Record of Survey.


Township 3 N, North of Range 17 East of 4 Principal Meridian as presented by the courses and distances on the following plat, and annexed field-notes of survey:

Established the center of the section at the point of intersection of STRAIGHT quarter lines.

Established all quarter-quarter corners upon the section boundary at proportional distances between known section and quarter section corners, according to the original field-notes of the Government survey.

Established all lost corners at proportionate distances between known corners, according to the original field notes of the Government survey.

No. 11

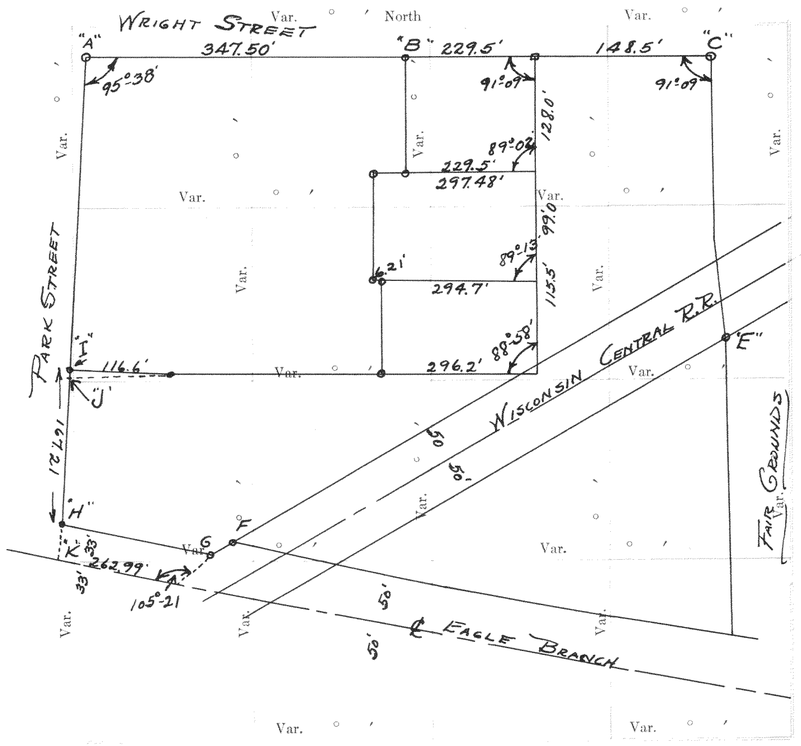

Plat of Section 31, Township 3 North, Range 17E of 4 Principal Meridian Scale 80 chains to 6 inches. The figures in red ink are the lengths of the lines as stated in the field-notes of the Government survey.

Declination of the Magnetic Meridian from the True Meridian.....

Surveyed and sub-divided.....A. D. 1 , in accordance with the State Laws and Instructions of the Commissioner of the General Land office, and recorded on pages .....of Register in the County Clerk's office.

Witness my hand this 20 day of Feb, 1933 A. D. 1

Floyd S. Jensen County SURVEYOR.

Surveyed Sept & Oct, 1932.

DESCRIPTION

OF SECTION, QUARTER SECTION AND QUARTER QUARTER SECTION CORNERS

H. C. MILLER CO., MFG. STATIONERS, MILWAUKEE X15000

GOVERNMENT CORNERS	Bearing Trees	In. Dia.	Courses they bear	Links Distant	Bearing Trees	In. Dia.	Courses they bear	Links Distant	Bearing Trees	In. Dia.	Courses they bear	Links Distant	Bearing Trees	In. Dia.	Courses they bear	Links Distant
No.																
1. N. W. Sec. Cor. indentified,																
2. N. E. Sec. Cor. indentified,																
3. S. E. Sec. Cor. indentified,																
4. S. W. Sec. Cor. indentified,																
5. N. ¼ Sec. Cor. indentified,																
6. E. ¼ Sec. Cor. indentified,																
7. S. ¼ Sec. Cor. indentified,																
8. W. ¼ Sec. Cor. indentified,																
Subdivision Corners																
No.																
1. Center ¼ Sec. Cor.																
2. North ¼-¼s N. W. qr.,																
3. East ¼-¼s N. W. qr.,																
4. South ¼-¼s N. W. qr.,																
5. West ¼-¼s N. W. qr.,																
6. Center ¼-¼s N. W. qr.,																
7. North ¼-¼s N. E. qr.,																
8. East ¼-¼s N. E. qr.,																
9. South ¼-¼s N. E. qr.,																
10. Center ¼-¼s N. E. qr.,																
11. East ¼-¼s S. E. qr.,																
12. South ¼-¼s S. E. qr.,																
13. West ¼-¼s S. E. qr.,																
14. Center ¼-¼s S. E. qr.,																
15. South ¼-¼s S. W. qr.,																
16. West ¼-¼s S. W. qr.,																
17. Center ¼-¼s S. W. qr.																

NAMES OF SWORN ASSISTANTS

CHAINMEN	FLAGMEN	AXMEN

No. 11. Survey of lots and strip of land for John N. Harris.
Location — S. W¼ sec 31, T3N. R17E. being lots 14 ft. 5- Blk 7, lots 10, 11, 12, 5 ft. lot 9, 4, 6, 7- Blk 5 all of Arnold's Add to the city of Elkhorn, and land N.E. of these lots and South of the fair grounds.

Monuments — Could not locate any.

Procedure — Found the block corners at the intersection of Wright & Park Streets by measuring from the curb as directed by the city Engineer, Hobbs. Used the fair grounds fence on wright Street for the Street line as directed by above mentioned party.


Obtained Park street line by measuring from curbs.

Found that the lot measurements on Park Str. didn't check with plat so proportioned them according to recorded plat.


P. E was obtained by finding the intersection of Court Street & the Wis. Central R.R. and then measuring that angle and determining the old lines of a triangular 2 acres that was owned by Fryer. The south pt. of the triangle comes at E which is 7.2' N. of the Fair grounds fence. The tree at this pt. has old wires in it & we found old post holes which showed the position of the old fence to be on this line & that no 7.5' jog in the fence existed as is now found in present fence.


The ℄ of the old Wis. Central road was located by using the lines of construction, there being no old pts. known. The location of the change in R.O.W. was obtained from the Milwaukee Office of the C.M. & St. P & P.R.R.

Fair ℄

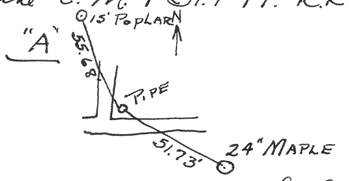


"J" — is a cross in the concrete drive.

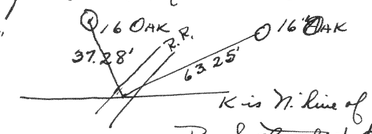

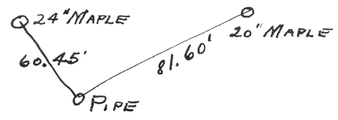

No. 12. Resurvey of lots 27-21 for Mrs. Jaeger of Cedar Pt. Park.
Location — Lots, 28, 27, 26, Walk, 25, 24, 23, 22, 21 in 1st Add to Cedar Pt. Park. Sec. 6, T1 N. R17E.

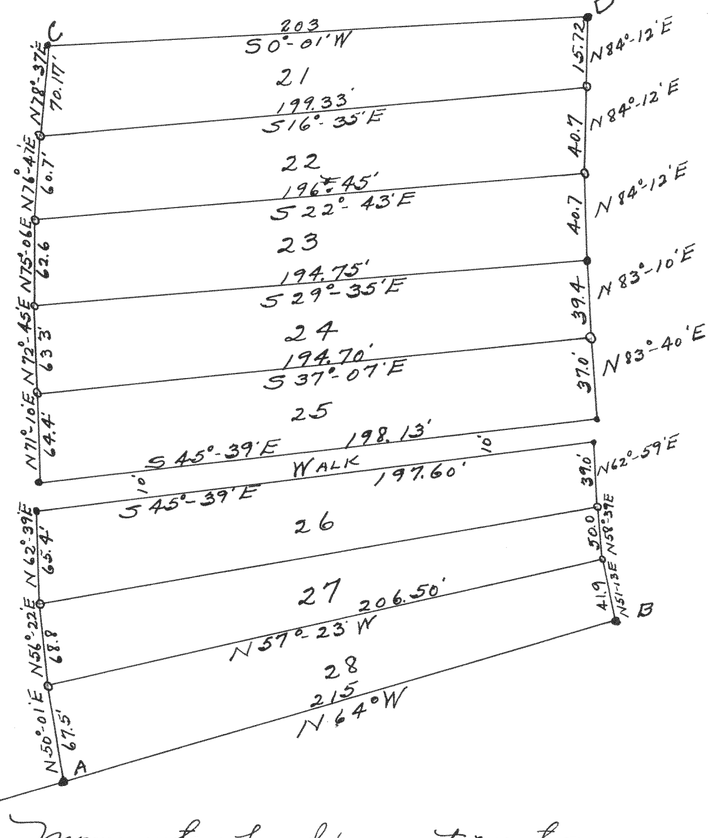

Monuments — Found permanent concrete monuments at A, B, C & D and at both ends of the walk.

Procedure — The monuments at A, B, C & D remained fixed and the other pts were changed enough to obtain the end lengths as given in the original plat except lot 21 which took the error that existed in lot 27.

- concrete monuments.
- o iron pipes.

Surveyed Sept 19 & 20, 1932
Recorded Feb 20, 1933
Lloyd S. Jensen
Co. Surveyor.