# Record of Survey.

no 147

East Troy

Township ....., North of Range ....., of 4 Principal Meridian as presented by the courses and distances on the following plat, and annexed field-notes of survey:

Established the center of the section at the point of intersection of STRAIGHT quarter lines.

Established all quarter-quarter corners upon the section boundary at proportional distances between known section and quarter section corners, according to the original field-notes of the Government survey.

Established all lost corners at proportionate distances between known corners, according to the original field notes of the Government survey.

Run W. line Land W. line of Blk I to be 33+198 +66+1-4E and fnd mon in line of Street to be 2695' North of Section corner, being 2' overplus, 42 rods = 693'. Take old post at NW of Z inn Lot & pt. 1'E & 1'S of walks at N. W. cor. of Blk 5 for E line of St. and on this line from pt. 66'N of NW corner of Blk 5 as mentioned N 396 feet and set stake for the N.W. corner of lot 3. From this turn R.A. E and at 396' set stake for the N.W. corner of piece. Produce this line 284.3 more to north side of fence post at corner and 289 and set stake in field from pt. made for SW. of Blk. I. East at R.A. 396' and set stake for SW. corner of piece.

Surveyed by William Child C.S. June 2-3, 1913

Recorded by Floyd S. Jensen C.S. Feb. 1, 1934

Plat of Section ....., Township ..... North, Range ..... of 4 Principal Meridian Scale 80 chains to 6 inches. The figures in red ink are the lengths of the lines as stated in the field-notes of the Government survey.

Declination of the Magnetic Meridian from the True Meridian .....

Surveyed and sub-divided ..... A. D. 1 , in accordance with the State Laws and Instructions of the Commissioner of the General Land office, and recorded on pages ..... of Register in the County Clerk's office.

**Witness** my hand this ..... day of ..... A. D. 1

..... SURVEYOR.

# DESCRIPTION

## OF SECTION, QUARTER SECTION AND QUARTER QUARTER SECTION CORNERS

N. C. MILLER CO., MFG. STATIONERS, MILWAUKEE X15000

| GOVERNMENT CORNERS | Bearing Trees | In. Dia. | Courses they bear | Links Distant | Bearing Trees | In. Dia. | Courses they bear | Links Distant | Bearing Trees | In. Dia. | Courses they bear | Links Distant | Bearing Trees | In. Dia. | Courses they bear | Links Distant |
|---|---|---|---|---|---|---|---|---|---|---|---|---|---|---|---|---|
| No. | | | | | | | | | | | | | | | | |
| 1. N. W. Sec. Cor. indentified, | | | | | | | | | | | | | | | | |
| 2. N. E. Sec. Cor. indentified, | | | | | | | | | | | | | | | | |
| 3. S. E. Sec. Cor. indentified, | | | | | | | | | | | | | | | | |
| 4. S. W. Sec. Cor. indentified, | | | | | | | | | | | | | | | | |
| 5. N. ¼ Sec. Cor. indentified, | | | | | | | | | | | | | | | | |
| 6. E. ¼ Sec. Cor. indentified, | | | | | | | | | | | | | | | | |
| 7. S. ¼ Sec. Cor. indentified, | | | | | | | | | | | | | | | | |
| 8. W. ¼ Sec. Cor. indentified, | | | | | | | | | | | | | | | | |
| **Subdivision Corners** | | | | | | | | | | | | | | | | |
| No. | | | | | | | | | | | | | | | | |
| 1. Center ¼ Sec. Cor. | | | | | | | | | | | | | | | | |
| 2. North ¼-⅛s N. W. qr., | | | | | | | | | | | | | | | | |
| 3. East ¼-⅛s N. W. qr., | | | | | | | | | | | | | | | | |
| 4. South ¼-⅛s N. W. qr., | | | | | | | | | | | | | | | | |
| 5. West ¼-⅛s N. W. qr., | | | | | | | | | | | | | | | | |
| 6. Center ¼-⅛s N. W. qr., | | | | | | | | | | | | | | | | |
| 7. North ¼-⅛s N. E. qr., | | | | | | | | | | | | | | | | |
| 8. East ¼-⅛s N. E. qr., | | | | | | | | | | | | | | | | |
| 9. South ¼-⅛s N. E. qr., | | | | | | | | | | | | | | | | |
| 10. Center ¼-⅛s N. E. qr., | | | | | | | | | | | | | | | | |
| 11. East ¼-⅛s S. E. qr., | | | | | | | | | | | | | | | | |
| 12. South ¼-⅛s S. E. qr., | | | | | | | | | | | | | | | | |
| 13. West ¼-⅛s S. E. qr., | | | | | | | | | | | | | | | | |
| 14. Center ¼-⅛s S. E. qr., | | | | | | | | | | | | | | | | |
| 15. South ¼-⅛s S. W. qr., | | | | | | | | | | | | | | | | |
| 16. West ¼-⅛s S. W. qr., | | | | | | | | | | | | | | | | |
| 17. Center ¼-⅛s S. W. qr. | | | | | | | | | | | | | | | | |

no 148 Smith Estate – East Troy

Found stake set for NW. corner of Blk. also 198' E. for NE corner and 168.85 being corner of Burton Lot. Set stakes on W. line at 84.4 from corner, also on N. at 99 from corner and from this ran S. parallel to W. line 84.4 and set stake for SE. corner of lot and 344 more & set stake for SW. corner of NE. lot and 98.8 E. of this for SE of same. Then 50 S. of this for SE. of piece being 1.3 N. of post of fence.

Surveyed by William Child C.S. June 22, 1909


Recorded by Floyd S. Jensen C.S. Feb. 2, 1934

## NAMES OF SWORN ASSISTANTS

| CHAINMEN | FLAGMEN | AXMEN |
|---|---|---|
| | | |

No 149

Block 7 Carr Stay

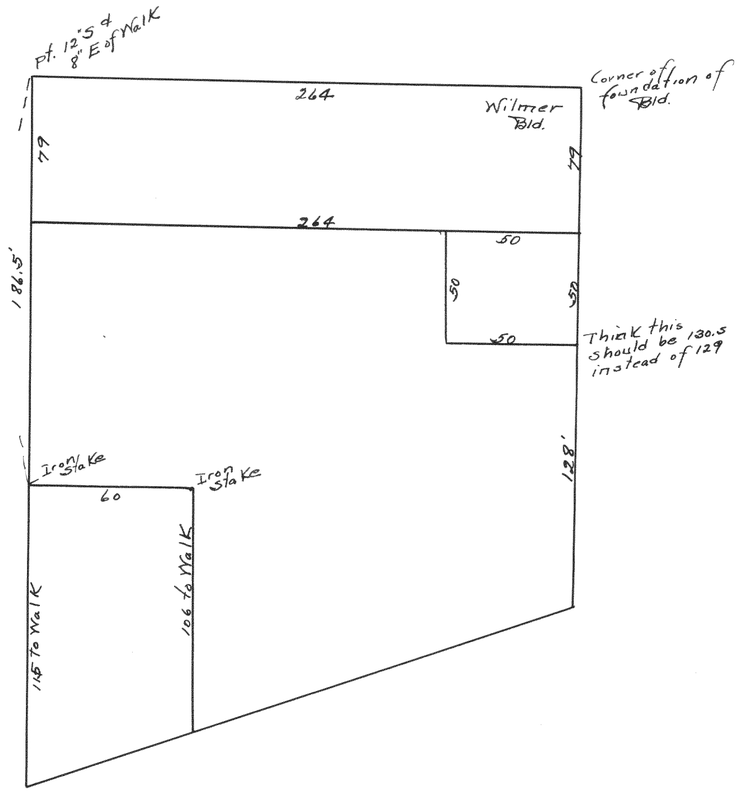


Otto Zinn

From NE. corner being NE. corner of brick work of Wilmer Bros. store W. 264' and made point for NW cor. of Blk., 66 more made pt. for NE of Blk. 8, from best of evidence I can gain & believe post at SE. corner is corner of Blk. Drive tacks in side of this post, make line 66' E of this for W. of Blk. 7

By referring to deed of Shayer to - given before the village was platted, I find a description, Beginning 2.55 chains N. of section corner W 83' N 56' E 83 S 50, I believe This to be lot 3 and from sec. N 2.55 = 168.3 + make pt. being 130'-7½' S. of N. line of block, make pt. 32' S of This & run W parallel with N. line of Blk. 83' for SW corner of Zinn & set iron pipe, 32' N. & set pipe not on corner, made pt. in walk 33' W for SE of lot 4 32' N of This marked walk for S line of lot 3.

This leaves 130'-7½" across lots 1 & 3 against 129 as in Plat & 128'-6" against 128 as in Plat, There being 2'-1" overplus in Blk.

Surveyed by William Child CS.
April 8, 1912
Recorded by Floyd S. Jones CS.
Feb. 2, 1934