No 150


# Record of Survey.

Township....., North of Range.....of 4 Principal Meridian as presented by the courses and distances on the following plat, and annexed field-notes of survey:

Established the center of the section at the point of intersection of STRAIGHT quarter lines.

Established all quarter-quarter corners upon the section boundary at proportional distances between known section and quarter section corners, according to the original field-notes of the Government survey.

Established all lost corners at proportionate distances between known corners, according to the original field notes of the Government survey.

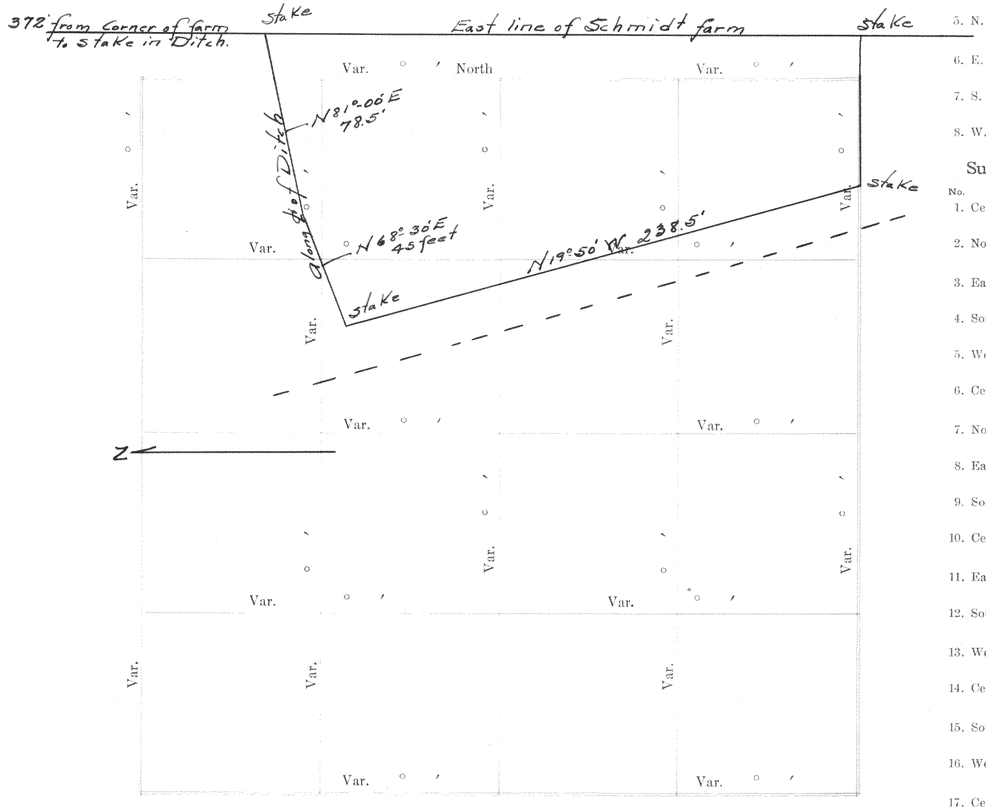


Plat of Section....., Township.....North, Range.....of 4 Principal Meridian Scale 80 chains to 6 inches. The figures in red ink are the lengths of the lines as stated in the field-notes of the Government survey.

Declination of the Magnetic Meridian from the True Meridian.....

Surveyed and sub-divided.....A. D. 1 , in accordance with the State Laws and Instructions of the Commissioner of the General Land office, and recorded on pages .....of Register in the County Clerk's office.

**Witness** my hand this.....day of.....A. D. 1

.....SURVEYOR.

52

# DESCRIPTION

## OF SECTION, QUARTER SECTION AND QUARTER QUARTER SECTION CORNERS

H. C. MILLER CO., MFG. STATIONERS, MILWAUKEE X15000

| GOVERNMENT CORNERS | Bearing Trees | In. Dia. | Courses they bear | Links Distant | Bearing Trees | In. Dia. | Courses they bear | Links Distant | Bearing Trees | In. Dia. | Courses they bear | Links Distant | Bearing Trees | In. Dia. | Courses they bear | Links Distant |
|---|---|---|---|---|---|---|---|---|---|---|---|---|---|---|---|---|
| No. | | | | | | | | | | | | | | | | |
| 1. N. W. Sec. Cor. indentified, | | | | | | | | | | | | | | | | |
| 2. N. E. Sec. Cor. indentified, | | | | | | | | | | | | | | | | |
| 3. S. E. Sec. Cor. indentified, | | | | | | | | | | | | | | | | |
| 4. S. W. Sec. Cor. indentified, | | | | | | | | | | | | | | | | |
| 5. N. ¼ Sec. Cor. indentified, | | | | | | | | | | | | | | | | |
| 6. E. ¼ Sec. Cor. indentified, | | | | | | | | | | | | | | | | |
| 7. S. ¼ Sec. Cor. indentified, | | | | | | | | | | | | | | | | |
| 8. W. ¼ Sec. Cor. indentified, | | | | | | | | | | | | | | | | |
| **Subdivision Corners** | | | | | | | | | | | | | | | | |
| No. | | | | | | | | | | | | | | | | |
| 1. Center ¼ Sec. Cor. | | | | | | | | | | | | | | | | |
| 2. North ¼-¼s N. W. qr., | | | | | | | | | | | | | | | | |
| 3. East ¼-¼s N. W. qr., | | | | | | | | | | | | | | | | |
| 4. South ¼-¼s N. W. qr., | | | | | | | | | | | | | | | | |
| 5. West ¼-¼s N. W. qr., | | | | | | | | | | | | | | | | |
| 6. Center ¼-¼s N. W. qr., | | | | | | | | | | | | | | | | |
| 7. North ¼-¼s N. E. qr., | | | | | | | | | | | | | | | | |
| 8. East ¼-¼s N. E. qr., | | | | | | | | | | | | | | | | |
| 9. South ¼-¼s N. E. qr., | | | | | | | | | | | | | | | | |
| 10. Center ¼-¼s N. E. qr., | | | | | | | | | | | | | | | | |
| 11. East ¼-¼s S. E. qr., | | | | | | | | | | | | | | | | |
| 12. South ¼-¼s S. E. qr., | | | | | | | | | | | | | | | | |
| 13. West ¼-¼s S. E. qr., | | | | | | | | | | | | | | | | |
| 14. Center ¼-¼s S. E. qr., | | | | | | | | | | | | | | | | |
| 15. South ¼-¼s S. W. qr., | | | | | | | | | | | | | | | | |
| 16. West ¼-¼s S. W. qr., | | | | | | | | | | | | | | | | |
| 17. Center ¼-¼s S. W. qr. | | | | | | | | | | | | | | | | |

Plat of survey for August Kunz on the South west quarter of Section No. 1, T 4 N, R 18 E, being the township of East Troy.

Surveyed by William Child CS

Recorded by Floyd S. Jensen CS.


Feb. 2, 1934

## NAMES OF SWORN ASSISTANTS

| CHAINMEN | FLAGMEN | AXMEN |
|---|---|---|
| | | |

No 151

EAST TROY

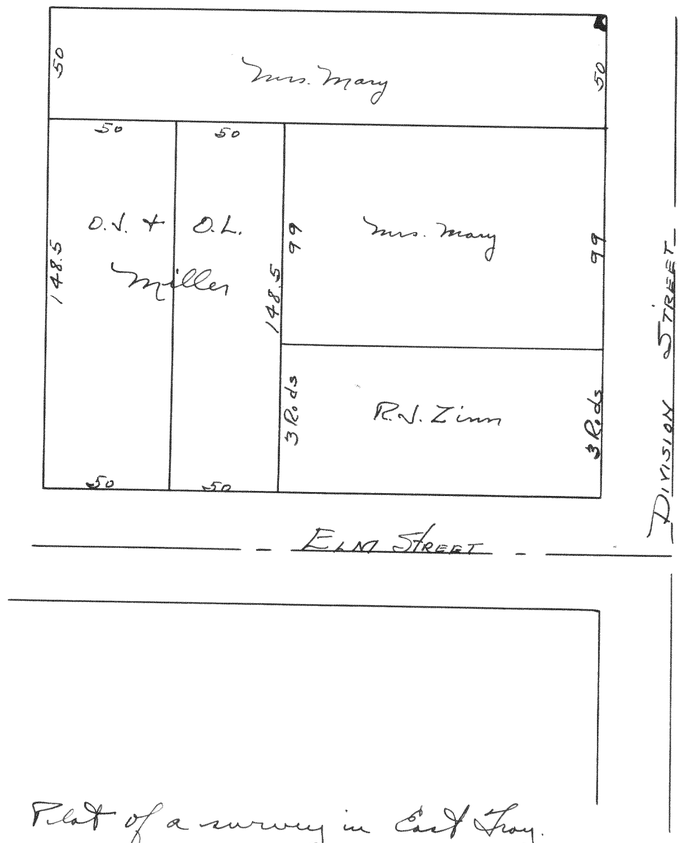


Plat of a survey in East Troy.

Surveyed by William Child C.S.

Recorded by Floyd S. Jensen C.S.

Feb. 3, 1934

No 152

A. E. Matheson

From NE and north west corner of Homer Brooks lot as now fenced, north 11 rods and drove iron stakes, which stakes were accepted as line and are 14.80 South of East qr. post, from these stakes north 2.26 to fence.

Surveyed by William Child C.S.
Feb. 5, 1900

Recorded by Floyd S. Jensen C.S.
Feb. 3, 1934