Record of Survey.

No 163

Township....., North of Range.....of 4 Principal Meridian as presented by the courses and distances on the following plat, and annexed field-notes of survey:

Established the center of the section at the point of intersection of STRAIGHT quarter lines.

Established all quarter-quarter corners upon the section boundary at proportional distances between known section and quarter section corners, according to the original field-notes of the Government survey.

Established all lost corners at proportionate distances between known corners, according to the original field notes of the Government survey.

Elkhorn

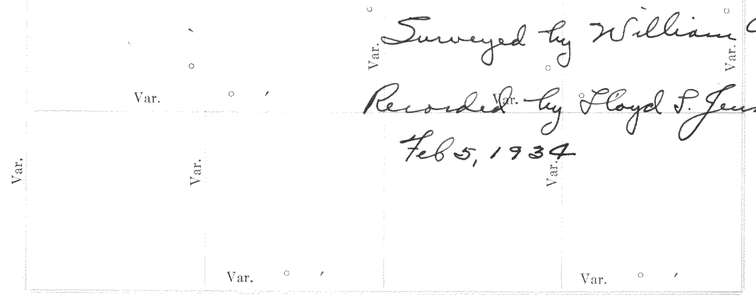
Beginning Var. at the North point of intersection of C. boundry of East St. to S. boundry of S. St. being NW. corner of block No I of Elderkin's Add; Thence East along the South boundry Var. of Park ~~Street~~ 133'-4"; Thence Var. S 245.5'; W 133.4' to a post in East boundry of East Street; Thence N. 245.5 ft. to place of beginning

In a run on a 10 foot offset E. from the Nat SE. corner of Hastings's shop, found this Var. bine 4 ft. W of the line of center of St. as run from the north.

Surveyed by William Child C.S.

Recorded by Floyd S. Jensen C.S.

Feb 5, 1934


Var.
Var.
Var.

no 165

Elkhorn
Block 14

Found west side of block to be 501.8

Found east side of block to be 502

Surveyed by William Child CS.
March 10, 1908

Recorded by Floyd S. Jensen CS.
Feb. 5, 1934

no 166

Block 24 - Elkhorn

At N.W. corner of Blk. found iron stake
measured S 336.5 to stake set by former survey
as being 3.5' S. of SW. corner of Lot, 336.5 - 3.5 = 333'
Distance on plat being 330' it gives .75 of a foot to
each 82.5' or 83.25 for each lot or 166.5 as the length
of lots 1, 2 & 3

Ran North line of Blk. and on E. of Blk. ran
S 166.5 & ran line across Blk for S. end of
lots 1, 2 & 3, from this line set 75 ft. across
lots 2 & 3 according to Rosenbauer deed & 2 feet 1 in.
N. of this ran line that hits Mahoney's Cave.

Surveyed by William Child CS.
April 21, 1909

Recorded by Floyd S. Jensen CS.
Feb. 5, 1934