Record of Survey.

no 167

Blk. 15 Elkhorn

Township ..., North of Range ...of 4 Principal Meridian as presented by the courses and distances on the following plat, and annexed field-notes of survey:

Established the center of the section at the point of intersection of STRAIGHT quarter lines.

Established all quarter-quarter corners upon the section boundary at proportional distances between known section and quarter section corners, according to the original field-notes of the Government survey.

Established all lost corners at proportionate distances between known corners, according to the original field-notes of the Government survey.

SE of SE of lot 9 found iron stake set by former survey, at NE of Park found iron stake measured E 66-7 found iron stake set by Tubbs from this stake sighted line to stake at NW of Blk. 21 made pt. at NE of Blk 20 and from this Pt. N to NE of lot 9 Blk 15 found surplus of 30 inches, gave lots 9 & 12 21.4 inches + St. 8.6 in 4" set cor. of Blk. 15. From NW of Blk 20 East to NW cor. of 21 found surplus of 38 inches. Gave Sts. 1/5 of surplus distance - 7.6 inches, making Street 66'- 7.6" wide, set iron stake for NE of Blk 20, leaving 30.4" surplus in Blk., set iron stake in center of Blk. being 16 inches W. of line of fence.

Surveyed by William Child C.S. July 12, 1901

Recorded by Floyd S. Jones C.S. Feb 5, 1934

Var. North Var.

Var. Var.

Var. Var.

Var. Var.

Plat of Section ..., Township ...North, Range ...of 4 Principal Meridian Scale 80 chains to 6 inches. The figures in red ink are the lengths of the lines as stated in the field-notes of the Government survey.

Declination of the Magnetic Meridian from the True Meridian ...

Surveyed and sub-divided ...A. D. 1 , in accordance with the State Laws and Instructions of the Commissioner of the General Land office, and recorded on pages ...of Register in the County Clerk's office.

Witness my hand this ...day of ...A. D. 1

...SURVEYOR.

DESCRIPTION

OF SECTION, QUARTER SECTION AND QUARTER QUARTER SECTION CORNERS


H. C. MILLER CO. MFG. STATIONERS, MILWAUKEE X15000

GOVERNMENT CORNERS	Bearing Trees	In. Dia.	Courses they bear	Links Distant	Bearing Trees	In. Dia.	Courses they bear	Links Distant	Bearing Trees	In. Dia.	Courses they bear	Links Distant	Bearing Trees	In. Dia.	Courses they bear	Links Distant
No.																
1. N. W. Sec. Cor. indentified,	no 168		S. Latham - Block 26 of Elkhorn													
2. N. E. Sec. Cor. indentified,																
3. S. E. Sec. Cor. indentified,																
4. S. W. Sec. Cor. indentified,																
5. N. 1/4 Sec. Cor. indentified,																
6. E. 1/4 Sec. Cor. indentified,																
7. S. 1/4 Sec. Cor. indentified,																
8. W. 1/4 Sec. Cor. indentified,																
Subdivision Corners																
No.																
Center 1/4 Sec. Cor.																
2. North 1/4-1/8 N. W. qr.,																
3. East 1/4-1/8 N. W. qr.,																
4. South 1/4-1/8 N. W. qr.,																
5. West 1/4-1/8 N. W. qr.,																
6. Center 1/4-1/8 N. W. qr.,																
7. North 1/4-1/8 N. E. qr.,																
8. East 1/4-1/8 N. E. qr.,																
9. South 1/4-1/8 N. E. qr.,																
10. Center 1/4-1/8 N. E. qr.,																
11. East 1/4-1/8 S. E. qr.,																
12. South 1/4-1/8 S. E. qr.,																
13. West 1/4-1/8 S. E. qr.,																
14. Center 1/4-1/8 S. E. qr.,																
15. South 1/4-1/8 S. W. qr.,																
16. West 1/4-1/8 S. W. qr.,																
17. Center 1/4-1/8 S. W. qr.																

Found N. of lot 485 to have 33 inches surplus making N. of 5 133'-4 1/2", Pt. SE. of fence post E iron Pt. in center of post at SW. of Blk. to stake at SW of 26 made line & from the line N 365.4' to SE of lot I, from SW. of 3, 5183 iron stake, 365.2 cor. stake. From SE of 1, 5182'-2 to pt. known being N. side of wall, Hartwell stake, Being NE lot 9 from line of Street W 267 to W. line of block making center at 133'-6 found post on line from SE of 6 + SW of 7 pt. 18 Ft. N & ran line offset 12 more for barn and from this line N 182.6' to N. of 5, 152.6 + 12 + 18 = 182.6 ÷ 2 = 91.3 - 58.5 = 32.8. From NW of 5 E 32 Ft. Then S parallel to W. line 328' & set spike for cor. of piece surveyed. Then S 73' & set stake 5.5' west of true corner

Surveyed by William Child-C.S. July 12, 1901

Recorded by Floyd S. Jones C.S., Feb 5, 1934

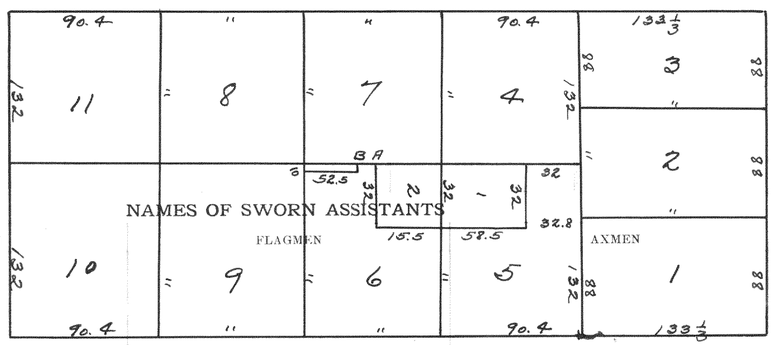

NAMES OF SWORN ASSISTANTS

CHAINMEN FLAGMEN AXMEN

no. 169 Blk. 21 Elkhorn


From stake at NW corner S. to point 99 N. of stake at NW. corner of block South 501 feet making 167 feet for East 165 foot lot and 83.5' for each 82.5 foot lot. From NW. corner South 167 this comes to center of point, 250.5 set stake for Southwest corner of lot 4

From Northeast corner South 250.5 set stake North of on street line.

Surveyed by ~~Floyd S. Jensen~~
William Child
CS
April 23
Recorded by Floyd S. Jensen CS.
Feb. 6, 1934

North

no 170

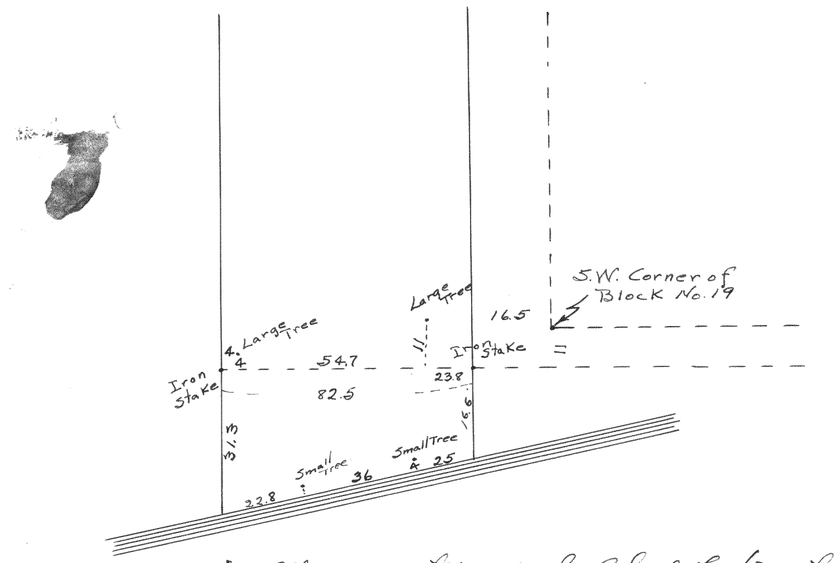

Plat of a portion of the lot of F. H. Marty in the City of Elkhorn, Walworth County, Wisconsin.

Elkhorn. July 11, 1913
Wm Child C.S.

Recorded by Floyd S. Jensen CS.
Feb. 6, 1934