Record of Survey.


no 178

Township....., North of Range.....of 4 Principal Meridian as presented by the courses and distances on the following plat, and annexed field-notes of survey:

Established the center of the section at the point of intersection of STRAIGHT quarter lines.

Established all quarter-quarter corners upon the section boundary at proportional distances between known section and quarter section corners, according to the original field-notes of the Government survey.

Established all lost corners at proportionate distances between known corners, according to the original field notes of the Government survey.

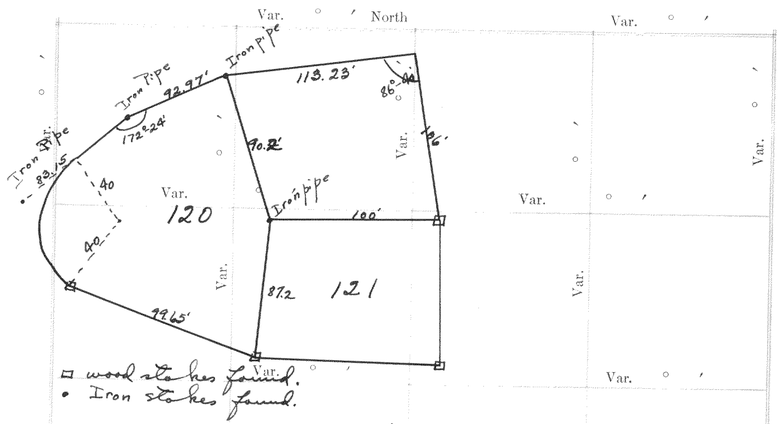

Lots 120 & 121 of Unit no 2 of Country Club estates at Fontana. Original pipes & wood stakes were found as shown, measured destances are given which did not in every instance agree with the original plat.

Description of parcel lying West of above lot 121 —

Beginning at the northwest corner of lot 121 of Unit no 2 of Country Club Estates, which is located in the Village of Fontana, State of Wisconsin; Thence westerly on the prolongation of the North line of said lot 121, 106 feet; Thence S 3°-00' E 113.23 feet to the most Westerly corner of lot 120 of said Unit; Thence N 81° 25' E 90.2 feet; Thence N 5°- 47' E 100 to the place of beginning.

Plat of Section....., Township....., North, Range.....of the Principal Meridian. Scale 80 chains to 6 inches. The figures in red ink are the lengths of the lines as stated in the field-notes of the Government survey.

Declination of the Magnetic Meridian from the True Meridian.....

Floyd S. Jensen CS.

Surveyed and sub-divided..... Oct 30, 1933 accordance with the State Laws and Instructions of the Commissioner of the General Land office, and recorded on pages .....of Register in the County Clerk's office.

Witness my hand this.....day of.....A. D. 1

.....SURVEYOR.

DESCRIPTION

60


OF SECTION, QUARTER SECTION AND QUARTER QUARTER SECTION CORNERS

H. C. MILLER CO., MFG. STATIONERS, MILWAUKEE X15000

GOVERNMENT CORNERS	Bearing Trees	In. Dia.	Courses they bear	Links Distant	Bearing Trees	In. Dia.	Courses they bear	Links Distant	Bearing Trees	In. Dia.	Courses they bear	Links Distant	Bearing Trees	In. Dia.	Courses they bear	Links Distant
No.																
1. N. W. Sec. Cor. indentified,																
2. N. E. Sec. Cor. indentified,																
3. S. E. Sec. Cor. indentified,																
4. S. W. Sec. Cor. indentified,																
5. N. ¼ Sec. Cor. indentified,																
6. E. ¼ Sec. Cor. indentified,																
7. S. ¼ Sec. Cor. indentified,																
8. W. ¼ Sec. Cor. indentified,																
Subdivision Corners																
No.																
1. Center ¼ Sec. Cor.																
2. North ¼-⅛s N. W. qr.,																
3. East ¼-⅛s N. W. qr.,																
4. South ¼-⅛s N. W. qr.,																
5. West ¼-⅛s N. W. qr.,																
6. Center ¼-⅛s N. W. qr.,																
7. North ¼-⅛s N. E. qr.,																
8. East ¼-⅛s N. E. qr.,																
9. South ¼-⅛s N. E. qr.,																
10. Center ¼-⅛s N. E. qr.,																
11. East ¼-⅛s S. E. qr.,																
12. South ¼-⅛s S. E. qr.,																
13. West ¼-⅛s S. E. qr.,																
14. Center ¼-⅛s S. E. qr.,																
15. South ¼-⅛s S. W. qr.,																
16. West ¼-⅛s S. W. qr.,																
17. Center ¼-⅛s S. W. qr.																

no 179

1-16

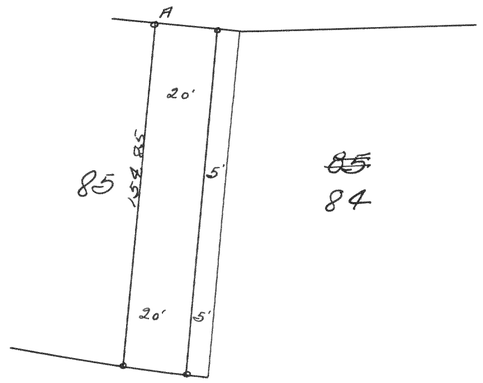

Survey in lot 85 of Unit no. 2 of Country Club Estates, located at Fontana, Wisconsin.

Said off 20 foot strips in lot 85 as shown on the above drawing. The pipe at A is 3' East of the true corner due to the fact that the true corner falls in a tree trunk.

o iron pipes.

Floyd S. Jensen CS
Nov. 1, 1933

NAMES OF SWORN ASSISTANTS

CHAINMEN FLAGMEN AXMEN

no 180 13-1-18

Resurvey and plat of "The Zuhlke Subdivision" The plat of which is on record in and for Walworth County in The Register of Deeds office.

Floyd T. Jensen C.S.
Oct. 1933


no. 181 13-1-18

Resurvey of The Subdivision of Lot 20 of Wm Elliotts Powers Lake Subdivision.

The plat of which is on record in and for Walworth County in The Register of Deeds Office.

Floyd T. Jensen C.S.
Oct. 1933

no 181

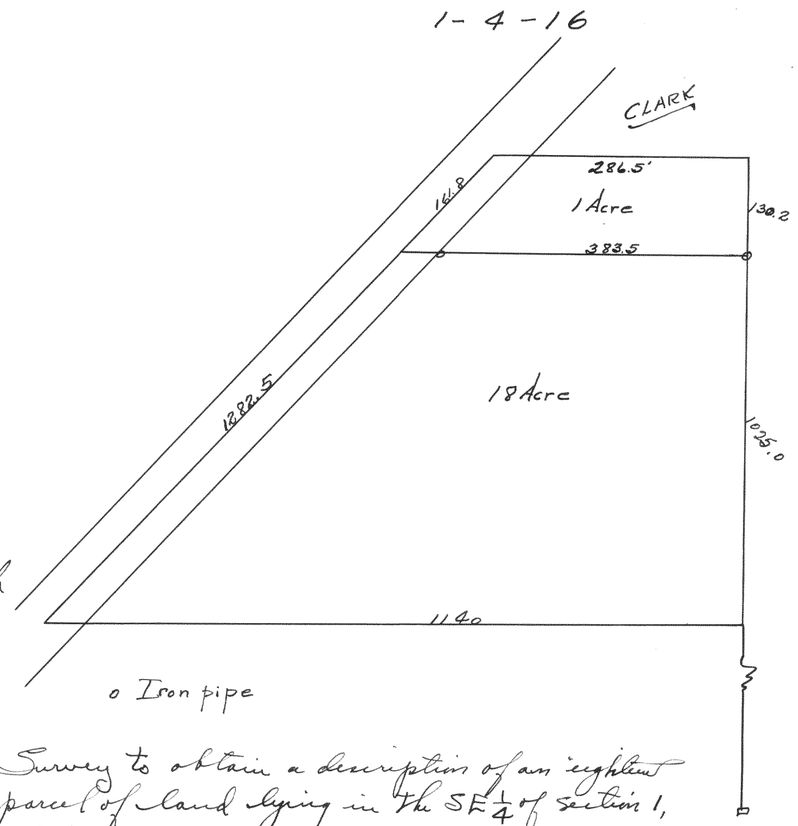

Survey to obtain a description of an eighteen acre parcel of land lying in the SE $\frac{1}{4}$ of section 1, T4N, R16E.

The description of which is as follows —