Record of Survey.

no 208


Troy Center

Township....., North of Range.....of 4 Principal Meridian as presented by the courses and distances on the following plat, and annexed field-notes of survey:

Established the center of the section at the point of intersection of STRAIGHT quarter lines.

Established all quarter-quarter corners upon the section boundary at proportional distances between known section and quarter section corners, according to the original field-notes of the Government survey.

Established all lost corners at proportionate distances between known corners, according to the original field notes of the Government survey.

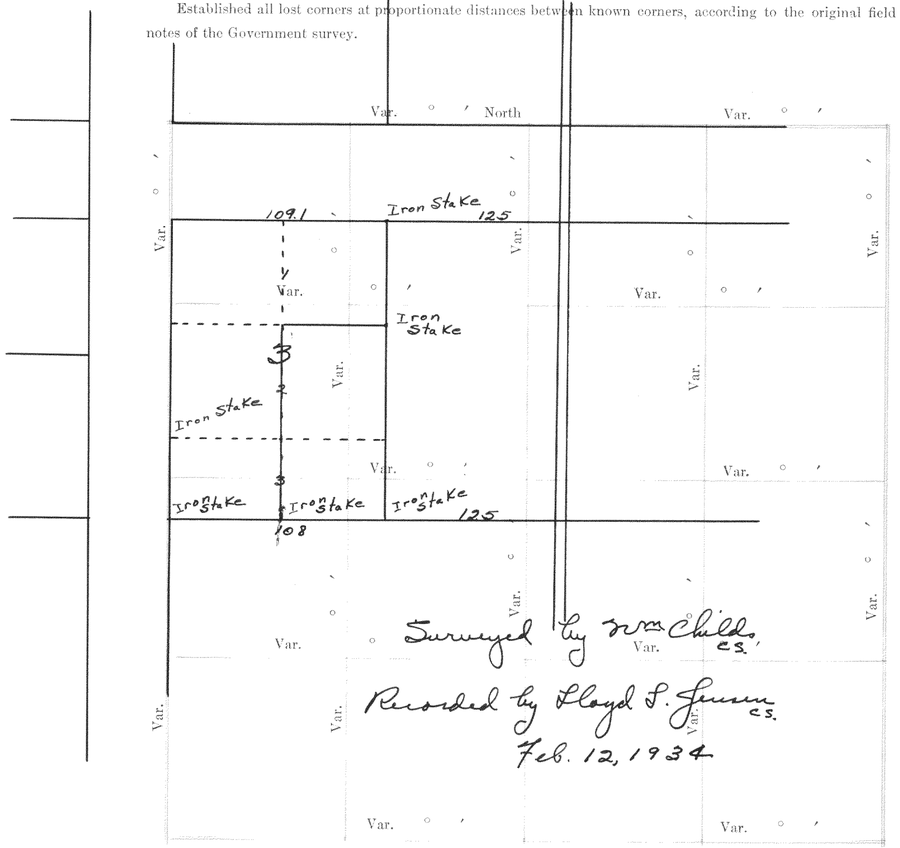

Plat of Section....., Township.....North, Range.....of 4 Principal Meridian Scale 80 chains to 6 inches. The figures in red ink are the lengths of the lines as stated in the field-notes of the Government survey.

Declination of the Magnetic Meridian from the True Meridian.....

Surveyed and sub-divided.....A. D. 1 , in accordance with the State Laws and Instructions of the Commissioner of the General Land office, and recorded on pages .....of Register in the County Clerk's office.

Witness my hand this.....day of.....A. D. 1

.....SURVEYOR.

DESCRIPTION

OF SECTION, QUARTER SECTION AND QUARTER QUARTER SECTION CORNERS

H. C. MILLER CO., MFG. STATIONERS, MILWAUKEE X15000

GOVERNMENT CORNERS	Bearing Trees	In. Dia.	Courses they bear	Links Distant	Bearing Trees	In. Dia.	Courses they bear	Links Distant	Bearing Trees	In. Dia.	Courses they bear	Links Distant	Bearing Trees	In. Dia.	Courses they bear	Links Distant
No.																
1. N. W. Sec. Cor. indentified,	no 209															
2. N. E. Sec. Cor. indentified,																
3. S. E. Sec. Cor. indentified,																
4. S. W. Sec. Cor. indentified,																
5. N. ¼ Sec. Cor. indentified,																
6. E. ¼ Sec. Cor. indentified,																
7. S. ¼ Sec. Cor. indentified,																
8. W. ¼ Sec. Cor. indentified,																
Subdivision Corners																
No.																
1. Center ¼ Sec. Cor.																
2. North ¼-⅛s N. W. qr.,																
3. East ¼-⅛s N. W. qr.,																
4. South ¼-⅛s N. W. qr.,																
5. West ¼-⅛s N. W. qr.,																
6. Center ¼-⅛s N. W. qr.,																
7. North ¼-⅛s N. E. qr.,																
8. East ¼-⅛s N. E. qr.,																
9. South ¼-⅛s N. E. qr.,																
10. Center ¼-⅛s N. E. qr.,																
11. East ¼-⅛s S. E. qr.,																
12. South ¼-⅛s S. E. qr.,																
13. West ¼-⅛s S. E. qr.,																
14. Center ¼-⅛s S. E. qr.,																
15. South ¼-⅛s S. W. qr.,																
16. West ¼-⅛s S. W. qr.,																
17. Center ¼-⅛s S. W. qr.																

35 + 26 - 4 - 17

Hart and Hewit

Began at south qr. post of 26 found stake and stones set new stake and stones, ran E, at 20.35 found stake for ⅛ post set by former survey, ran on to 40.70 and made post on bridge for corner, 3-10 N. of S. of bridge, ran back 11.50 and set stake, from this stake E. 3.72 Then north 8.54 + 4.40 + 3.78 to a point 1.16 E of a point that is S 82½ W 9.00 from a point on East line of section 17.80 N. of SE. corner from S. W. corner ran North parallel to this line 8.54 and set stake East of fence corner, Then North East to point on line. Ran 8.54 + 4.40 N 5.76 and set stake 16 in. North of post, Then North west 3.95 to point 9.00 S 82½ W of NE Corner of piece and set stake, being 3-8 N. of post, S. to east NE. corner is 23-9 E of tree and at SW cor. 4-10 SE. of tree.

From ⅛ post S 19.81 NW. corner of Odell 39.81 fence, E. along fence 20.34 stake, N 20.15 N. line of Odells, 40.09 corner.

Surveyed by Wm Child cs.
Nov. 22, 1907
Recorded by Floyd S. Jennes cs.
Feb. 12, 1934

NAMES OF SWORN ASSISTANTS

CHAINMEN	FLAGMEN	AXMEN

No 210 Troy

C. T. Adkins

W 139, S 12 W 187.5, 179.5 30 from corners of strip, N 203.5 aida 8.5, 26 from iron

Adkins description - Beginning 126 rods 3'-10" South of northeast corner Then N 53'-10", Leaving 122 rods 16' from corner, find iron stake set for this point, point agreed on is 8.5' South of this = 123 rods 8 feet from N.E corner, W 139' S 12°W 187.5 to fence post at southwest of Adkins set as fenced, Southeast along fence 179.5 to east line, North along line 203.5, Corner is 26 from iron stake on side of road, drive stake 2' S.W. of Northwest Corner.

Surveyed by Wm Child C.S.

Recorded by Floyd S. Jensen C.S.
Feb. 12, 1934

No 211 23426-4-17

Ivy and Swadda

Beginning at East qr. post of section 23 which is 35½ links East and 39½ S. of fence post at NW. corner, S 40.17, Southeast corner a stone. Set small hub at 30.17 Then N. 40.29 South qr. post drive stake, and 8.37½ west of qr. post on South line of section and set stake set stake at 20.14½ E. of qr post for ⅛ post. From East qr post west at 20.14½ set stake on true qr. line 29.14 more line of fence on West of Niedecken land and 31.30 more West qr. post. From stake 20.14½ west of qr. post South on ⅛ line set stake at 30.14 + 40.14½ ⅛ post and from ⅛ post on South 22.83 stake on bank of creek on west of niedecken piece, South from qr. line to stake on section line 40.06. South in Sec. 26 at 14.80 North of creek and 19.98 post from This post East 16.70½ post, Then S. 2.50 stake on South of fence post. Then SE 1200 stake on North bank of creek.

Surveyed by Wm Child C.S.
Nov. 13 + 14, 1905

Recorded by Floyd S. Jensen C.S.
Feb. 12, 1934