Record of Survey.

No 224


15-3-18

Township....., North of Range.....of 4 Principal Meridian as presented by the courses and distances on the following plat, and annexed field-notes of survey:

Established the center of the section at the point of intersection of STRAIGHT quarter lines.

Established all quarter-quarter corners upon the section boundary at proportional distances between known section and quarter section corners, according to the original field-notes of the Government survey.

Established all lost corners at proportionate distances between known corners, according to the original field-notes of the Government survey.

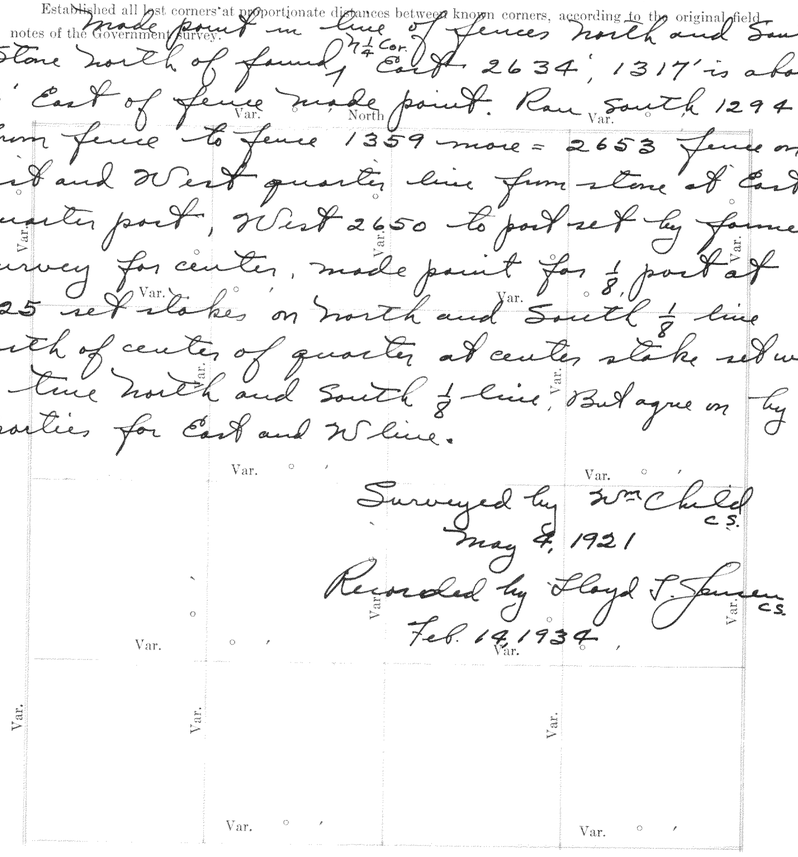

Plat of Section....., Township.....North, Range.....of 4 Principal Meridian Scale 80 chains to 6 inches. The figures in red ink are the lengths of the lines as stated in the field-notes of the Government survey.

Declination of the Magnetic Meridian from the True Meridian.....

Surveyed and sub-divided.....A. D. 1 , in accordance with the State Laws and Instructions of the Commissioner of the General Land office, and recorded on pages .....of Register in the County Clerk's office.

Witness my hand this.....day of.....A. D. 1

.....SURVEYOR.

DESCRIPTION

OF SECTION, QUARTER SECTION AND QUARTER QUARTER SECTION CORNERS

N. C. MILLER CO. MFG. STATIONERS, MILWAUKEE X15000

GOVERNMENT CORNERS	Bearing Trees	In. Dia.	Courses they bear	Links Distant	Bearing Trees	In. Dia.	Courses they bear	Links Distant	Bearing Trees	In. Dia.	Courses they bear	Links Distant	Bearing Trees	In. Dia.	Courses they bear	Links Distant
No.																
1. N. W. Sec. Cor. indentified,																
2. N. E. Sec. Cor. indentified,																
3. S. E. Sec. Cor. indentified,																
4. S. W. Sec. Cor. indentified,																
5. N. 1/4 Sec. Cor. indentified,																
6. E. 1/4 Sec. Cor. indentified,																
7. S. 1/4 Sec. Cor. indentified,																
8. W. 1/4 Sec. Cor. indentified,																
Subdivision Corners																
No.																
1. Center 1/4 Sec. Cor.																
2. North 1/4-1/8 N. W. qr.,																
3. East 1/4-1/8 N. W. qr.,																
4. South 1/4-1/8 N. W. qr.,																
5. West 1/4-1/8 N. W. qr.,																
6. Center 1/4-1/8 N. W. qr.,																
7. North 1/4-1/8 N. E. qr.,																
8. East 1/4-1/8 N. E. qr.,																
9. South 1/4-1/8 N. E. qr.,																
10. Center 1/4-1/8 N. E. qr.,																
11. East 1/4-1/8 S. E. qr.,																
12. South 1/4-1/8 S. E. qr.,																
13. West 1/4-1/8 S. E. qr.,																
14. Center 1/4-1/8 S. E. qr.,																
15. South 1/4-1/8 S. W. qr.,																
16. West 1/4-1/8 S. W. qr.,																
17. Center 1/4-1/8 S. W. qr.																

No 225

12-3-18

Survey for Lucile McDonald

Commencing at the Southwest corner of Section 1, Township 2 North, Range 18 East, in the County of Walworth, State of Wisconsin, running Thence East on the South line of said Section 14.75 chains, Thence North at right angles to said section line 10.50 chains, Thence west parallel with the South line of said section one 16.20 chains, Thence south 10.50 chains to the South line of section 2, Town aforesaid, Thence east on said south line 1.45 chains to the place of beginning, containing 17 Acres of land.


Surveyed by Wm Child C.S.
Sept. 26, 1908

Recorded by Floyd S Jensen C.S.
Feb. 14, 1934

NAMES OF SWORN ASSISTANTS

CHAINMEN	FLAGMEN	AXMEN


No 226 SW of 34-3-18

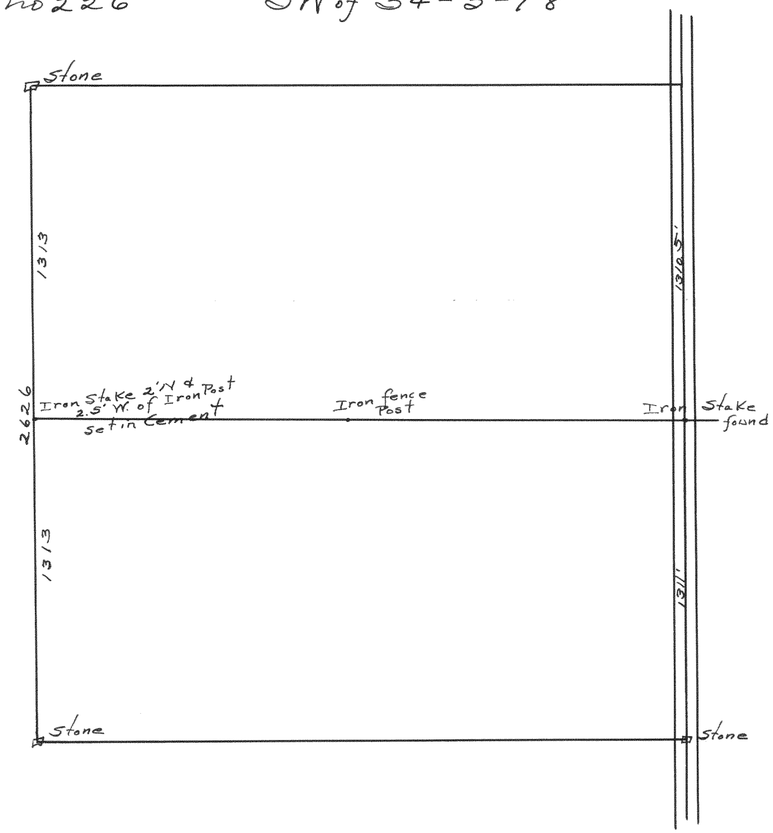

Surveyed by Wm Child C.S.

Recorded by Lloyd S. Jensen C.S. Feb. 14, 1934

No 227 3-18 Vienna

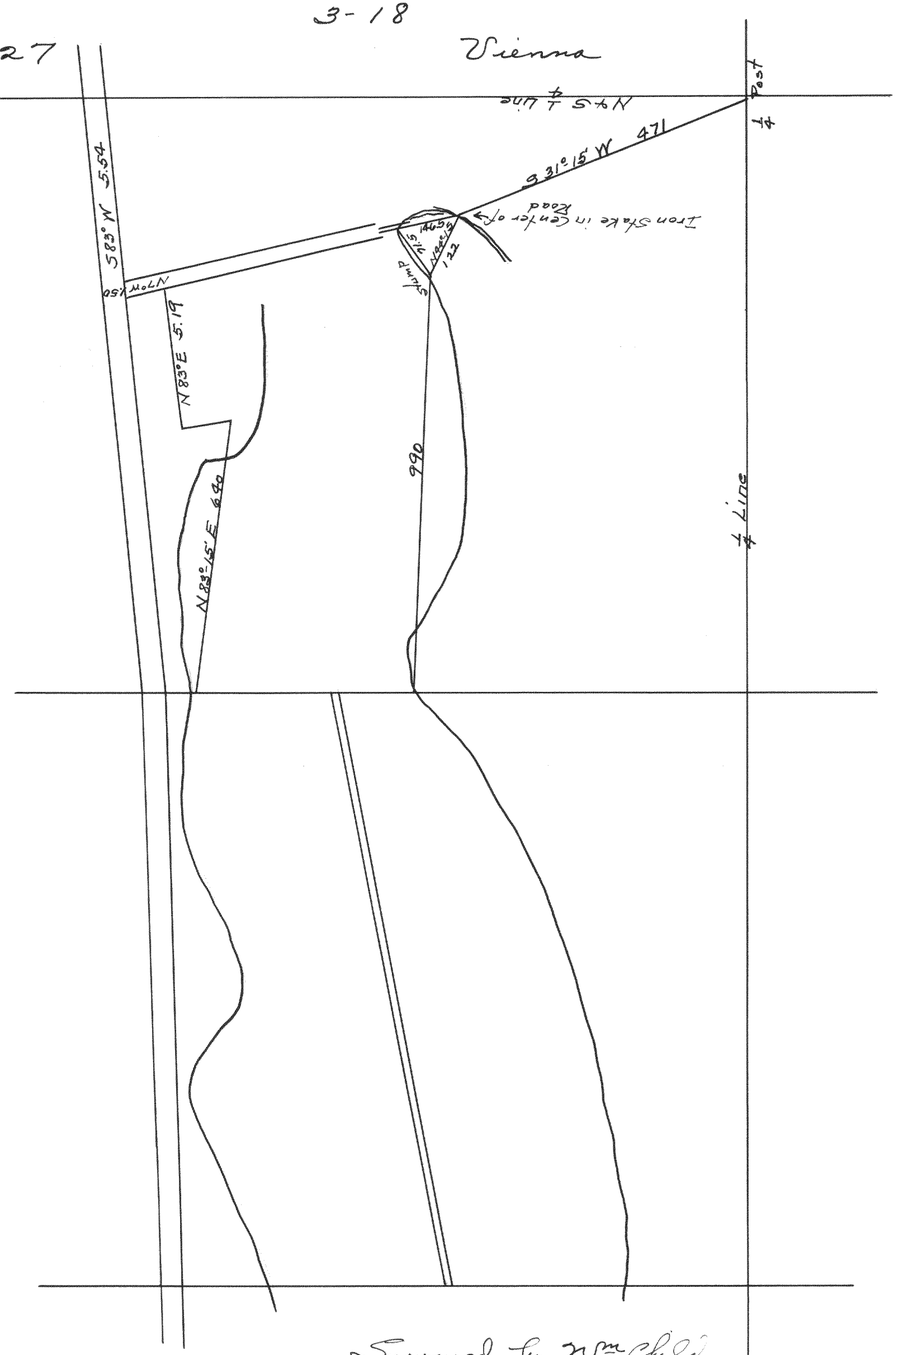

Surveyed by Wm Child C.S.
Recorded by Lloyd S. Jensen C.S.
Feb. 14, 1934