Record of Survey.

No 265


27-2-15

Township....., North of Range.....of 4 Principal Meridian as presented by the courses and distances on the following plat, and annexed field-notes of survey:

Established the center of the section at the point of intersection of STRAIGHT quarter lines.

Established all quarter-quarter corners upon the section boundary at proportional distances between known section and quarter section corners, according to the original field-notes of the Government survey.

Established all lost corners at proportionate distances between known corners, according to the original field notes of the Government survey.

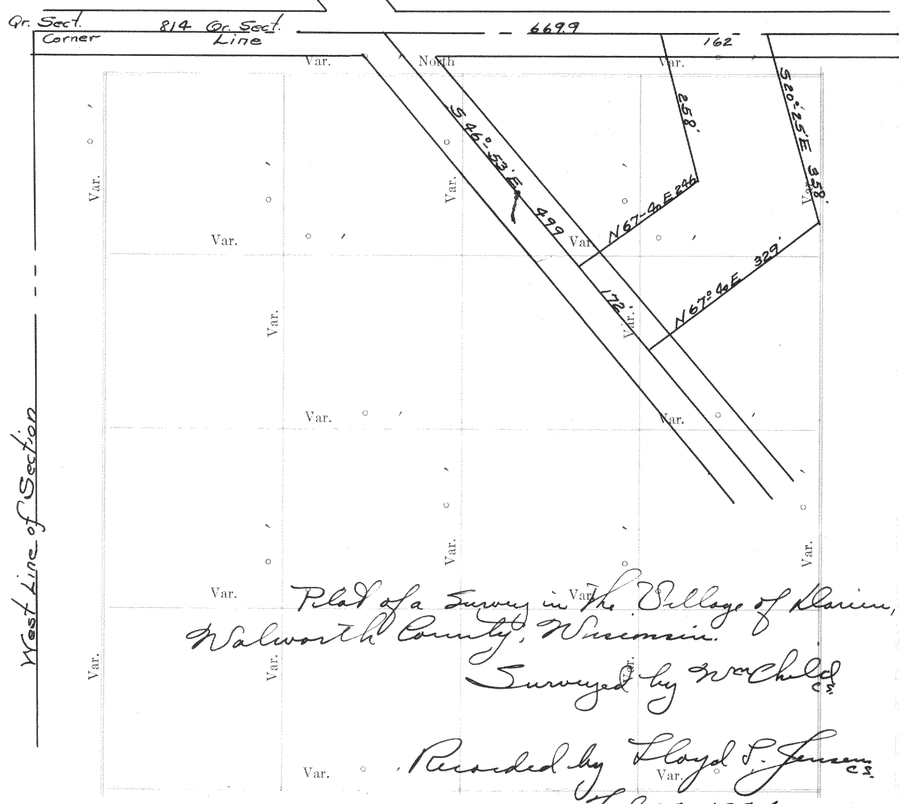

Plat of a Survey in the Village of Clarien, Walworth County, Wisconsin.

Surveyed by W. W. Child C.S.

Recorded by Lloyd P. Jensen C.S.

Feb. 23, 1934

Plat of Section....., Township.....North, Range.....of 4 Principal Meridian Scale 80 chains to 6 inches. The figures in red ink are the lengths of the lines as stated in the field-notes of the Government survey.

Declination of the Magnetic Meridian from the True Meridian.....

Surveyed and sub-divided.....A. D. 1 , in accordance with the State Laws and Instructions of the Commissioner of the General Land office, and recorded on pages .....of Register in the County Clerk's office.

Witness my hand this.....day of.....A. D. 1

.....SURVEYOR.

DESCRIPTION

OF SECTION, QUARTER SECTION AND QUARTER QUARTER SECTION CORNERS

N. C. MILLER CO., MFG. STATIONERS, MILWAUKEE X15000

GOVERNMENT CORNERS	Bearing Trees	In. Dia.	Courses they bear	Links Distant	Bearing Trees	In. Dia.	Courses they bear	Links Distant	Bearing Trees	In. Dia.	Courses they bear	Links Distant	Bearing Trees	In. Dia.	Courses they bear	Links Distant
No.																
1. N. W. Sec. Cor. indentified,																
2. N. E. Sec. Cor. indentified,																
3. S. E. Sec. Cor. indentified,																
4. S. W. Sec. Cor. indentified,																
5. N. ¼ Sec. Cor. indentified,																
6. E. ¼ Sec. Cor. indentified,																
7. S. ¼ Sec. Cor. indentified,																
8. W. ¼ Sec. Cor. indentified,																
Subdivision Corners																
No.																
1. Center ¼ S. Cor.,																
2. North ¼-¼s E. qr.,																
3. East ¼-¼s S. E. qr.,																
4. South ¼-¼s S. W. qr.,																
5. West ¼-¼s S. W. qr.,																
6. Center ¼-¼s S. W. qr.,																
7. North ¼-¼s E. qr.,																
8. East ¼-¼s S. E. qr.,																
9. South ¼-¼s S. E. qr.,																
10. Center ¼-¼s S. E. qr.,																
11. East ¼-¼s S. E. qr.,																
12. South ¼-¼s S. E. qr.,																
13. West ¼-¼s S. E. qr.,																
14. Center ¼-¼s S. E. qr.,																
15. South ¼-¼s S. E. qr.,																
16. West ¼-¼s S. W. qr.,																
17. Center ¼-¼s S. W. qr.,																

2 T 2 N - 15 E

No. 266 Description of Lib Prop. from Survey.

That certain piece or parcel of land in the Northeast Quarter of Section 27, T2N, R15E, being the Town of Clarien, Walworth Co., Wisconsin, and described as follows to wit:— Beginning at an iron stake on the Northwesterly side or end of Lot 6, in Blk. No 12 of Stone & Hopkins's Add. to the Village of Clarien, 3.3 (equalling 5 lks) Southwesterly from the NE corner of said Lot, and being the point heretofore claimed in previous deeds as being 5 lks. Southwesterly from the Northwest corner of Lot 5; Thence North 237 feet, more or less, to an iron stake, Thence N 66° E 305' to an iron stake and 376' to a point in the pond; Thence South 200' to an iron stake and 525' to the East side of a large fence post in line of one certain fence running E & W, Thence east along the line of said fence 404.6 feet to a large fence post in the line of one certain fence running South; Thence South along the line of said fence 580' to an iron stake & 747' to a pt. in the pond; Thence South 62° W 115' to an iron stake and 270' to an iron stake on the N Easterly line of 4th Ave. in said Add.; Thence N 28° W 198' (3 chains) to an iron stake at the most Southerly or Southeasterly corner of said plat; Thence S 62° W along the Northwesterly line of said plat 465.3 (7.05 chains) to the place of beginning, containing 9 acres of land.

Lots to 1, 2, 3, 4, 5, & 10, with the street adjoining, containing 1.75 Acres.

Surveyed by W. W. Child C.S.

NAMES OF SWORN ASSISTANTS

CHAINMEN

FLAGMEN

Recorded by Lloyd P. Jensen C.S.
Feb. 23, 1934

No. 267 Delavan City

Blk. 3 of T.P.A.D Subd.

Wm Brahem, Charles Page Hatters

At S.W. corner Fnd iron stake and 132 & 179.5 North iron stakes, From Southwest corner East 133 iron stake and 66.5 more remains of wood stake and drove iron stake.

133' more small stake at corner

133 West of Southeast and 132 North Fnd iron stake 165 set iron stake Northwest of Blk and on this line on North of Blk.

Surveyed by W.A. Child C.S.

Recorded by Lloyd S. Jensen C.S.
Feb. 23, 1934

No 268 Blk. 12, Delavan City

Mrs. Chenbo

From Southwest corner of Opera House South 16.5 to pt. 6" South of North end of cement walk. Then South 498' found stake hole for S.W. of Blk. 13½' E & 12" N. of walks, at 142.28 being 2/7 of distance make pt. for N.W. corner of lot 17, Being 8" S. of seam in walk and 6" on walk, at 284.56 make pt. for southwest corner of lot 20, 2⅓" E. of walk and 16" S. of seam in walk, on E. of Blk. Fnd iron stake for NE. corner of lot 18 in a former survey, ran line from this West 332.8" to N.W. of 17 set iron stake at 166.4 from corners and on North side of fence post, Fnd iron stake 8' S. on S of post, along E. of Blk. from NE of 18, S. 213.4 Fnd iron stake set by former survey for SE. corner of 22 and 142.2 more Fnd stake set for corner of Blk. 16.5" N. and 7" W. of walks, from stake set for NE of 17 S. 142.28 and set iron stake for SE of 20, Being in line of fence S. and 166.4 E. of West line

Surveyed by W.A. Child C.S.
Sept. 6, 1914

Recorded by Lloyd S. Jensen C.S.
Feb. 23, 1934