Record of Survey.


No 277

Township ..... Heiss Subdivision of Delavan, North of Range ..... of 4 Principal Meridian as presented by the courses and distances on the following plat, and annexed field-notes of survey:

Established the center of the section at the point of intersection of STRAIGHT quarter lines.

Established all quarter-quarter corners upon the section boundary at proportional distances between known section and quarter section corners, according to the original field-notes of the Government survey.

Established all lost corners at proportionate distances between known corners, according to the original field notes of the Government survey.

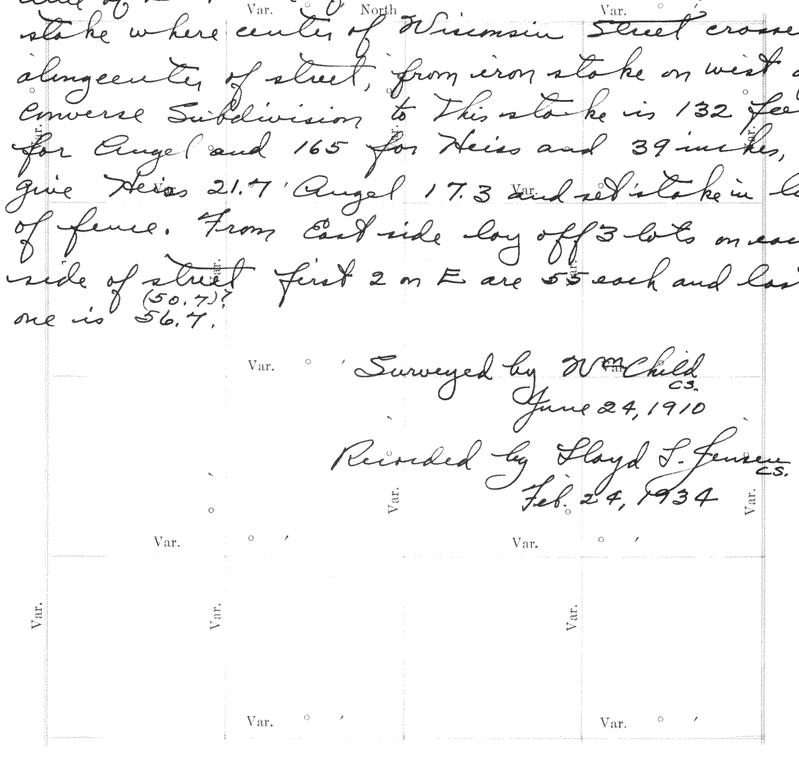

Ran line of Wisconsin as used by Railroad surveyors and as used in Converse Sub. Ran line of East side of Barnards Subdivision and set stake where center of Wisconsin Street crosses, along center of street, from iron stake on west of Converse Subdivision to this stake is 132 feet for Angel and 165 for Heiss and 39 inches, give Heiss 21.7' Angel 17.3 and set stake in line of fence. From East side lay off 3 lots on each side of street (50.7)? first 2 on E are 55 each and last one is 56.7.

Surveyed by Wm Child C.S.
June 24, 1910

Recorded by Floyd L. Jensen C.S.
Feb. 24, 1934

Plat of Section ....., Township ..... North, Range ..... of 4 Principal Meridian Scale 80 chains to 6 inches. The figures in red ink are the lengths of the lines as stated in the field-notes of the Government survey.

Declination of the Magnetic Meridian from the True Meridian .....

Surveyed and sub-divided ..... A. D. 1 , in accordance with the State Laws and Instructions of the Commissioner of the General Land office, and recorded on pages ..... of Register in the County Clerk's office.

Witness my hand this ..... day of ..... A. D. 1

..... SURVEYOR.

DESCRIPTION

OF SECTION, QUARTER SECTION AND QUARTER QUARTER SECTION CORNERS

H. C. MILLER CO., MFG. STATIONERS, MILWAUKEE X15000

GOVERNMENT CORNERS	Bearing Trees	In. Dia.	Courses they bear	Links Distant	Bearing Trees	In. Dia.	Courses they bear	Links Distant	Bearing Trees	In. Dia.	Courses they bear	Links Distant	Bearing Trees	In. Dia.	Courses they bear	Links Distant
No.																
1. N. W. Sec. Cor. indentified,																
2. N. E. Sec. Cor. indentified,																
3. S. E. Sec. Cor. indentified,																
4. S. W. Sec. Cor. indentified,																
5. N. ¼ Sec. Cor. indentified,																
6. E. ¼ Sec. Cor. indentified,																
7. S. ¼ Sec. Cor. indentified,																
8. W. ¼ Sec. Cor. indentified,																
Subdivision Corners.																
No.																
1. Center Sec. Cor.,																
2. North ¼ Cor.,																
3. East ¼ Cor.,																
4. South ¼ Cor.,																
5. West ¼ Cor.,																
6. Center ¼-¼s,																
7. North ¼-¼s,																
8. East ¼-¼s,																
9. South ¼-¼s,																
10. Center ¼-¼s,																
11. East ¼-¼s,																
12. South ¼-¼s,																
13. West ¼-¼s,																
14. Center ¼-¼s,																
15. South ¼-¼s S. W. qr.,																
16. West ¼-¼s S. W. qr.,																
17. Center ¼-¼s S. W. qr.																

No. 278 Certificate of Survey

I do hereby certify that I did on the 5th day of May 1911, and by the direction of C. S. Van Svessenlel, City Attorney for the City of Delavan, Walworth County, Wisconsin, survey of a certain piece of land to be used as a street and a description of which is as follows, to-wit:-

Beginning at a stake at the Southeast corner of Lot 10 of the Plat of Katie A. Lothrop's 2nd Add. to the Village of Delavan, Thence East on a line which line is the most Southerly line of Lots 8, 9 & 10 of said addition produced to the West line of Lot 4 of J. B. Stevendorf's Add. to said Village 169 feet more or less to the East line of said Lot 4, being the West line of Eighth Street, Thence South along the West line of said street and the East line of Lots 4 and 5, 64 feet, Thence West parallel with and 64 feet South of the above mentioned line running East through said Lot 4 169 feet more or less to the West line of said Lot five, being also the East line of said Katie A. Lothrop's Addition, Thence North on the West line of said Lots 5 & 4, 64 feet to the place of beginning, taking a strip of land about 21 feet in width off from the South side of said Lot 4 and a strip about 43 feet in width off from the North side of Lot 5 aforesaid

Wm Child C.S.
May 12, 1911

Recorded by Floyd L. Jensen C.S.
Feb. 24, 1934

NAMES OF SWORN ASSISTANTS

CHAINMEN	FLAGMEN	AXMEN

No. 279 Delavan City

Description from survey

Beginning at a stake on the Southeasterly side of Racine Street which is N56°-6'E 6.38 chains from the intersection of the one-eighth section line running north and south through the northwest 1/4 of Section 17-2-16, and said point of beginning being also the northwesterly corner of one certain piece or parcel of land conveyed by the party of the first part to F.A. Southwick by deed dated November 8, 1912, and recorded in the Register of Deeds office in and for said County in Vol. 135 of Deeds, on page 200; Thence S 33°-54'E along the line of lands so conveyed 216'; Thence S56°-06'W 66' to the lands of Austin; Thence N33°-54'W along said Austin's line 216 feet to the Southeasterly line of said Racine Street; Thence N56°-06'E 66' to the place of beginning.

Surveyed by Wm Child CS

Recorded by Floyd S. Jensen CS.
Feb. 24, 1934

No 280 Delavan City

"Katie A. Lathrop's 2nd Add."

I William Child, County Surveyor of Walworth County, Wisconsin, do hereby certify That I have on This Sixteenth day of November, 1904, made a resurvey of a portion of "Katie A. Lathrop's Second Addition to The Village (now City) of Delavan", and find That the line as established on the land by a fence and stakes, and which line has always been supposed to be The South line of lands conveyed by Ann Mary Phillips to Owen Griffen December 28, 1883, and afterward conveyed by Owen Griffen to Mary Griffen on April 29, 1904, is the same line as recognized by Mr. Stubbs, The surveyor who on The 18th day of December, 1897, surveyed and platted "Katie A. Lathrop's second Addition as above mentioned

William Child CS.

Recorded by Floyd S. Jensen CS.
Feb. 24, 1934