# Record of Survey.


No 306

Township....., North of Range.....of 4 Principal Meridian as presented by the courses and distances on the following plat, and annexed field-notes of survey:

Established the center of the section at the point of intersection of STRAIGHT quarter lines.

Established all quarter-quarter corners upon the section boundary at proportional distances between known section and quarter section corners, according to the original field-notes of the Government survey.

Established all lost corners at proportionate distances between known corners, according to the original field notes of the Government survey.

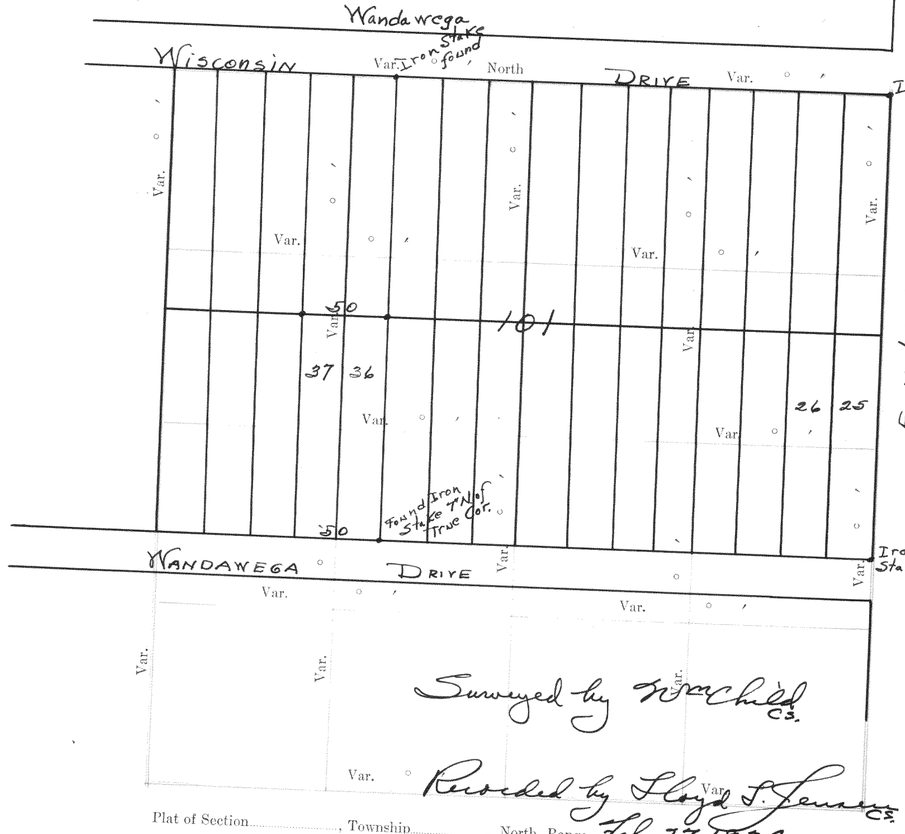


Plat of Section....., Township.....North, Range.....East of 4 Principal Meridian Scale 80 chains to 6 inches. The figures in red ink are the lengths of the lines as stated in the field-notes of the Government survey.

Declination of the Magnetic Meridian from the True Meridian.....

Surveyed and sub-divided.....A. D. 1 , in accordance with the State Laws and Instructions of the Commissioner of the General Land office, and recorded on pages .....of Register in the County Clerk's office.

**Witness** my hand this.....day of.....A. D. 1

.....SURVEYOR.

# DESCRIPTION

## OF SECTION, QUARTER SECTION AND QUARTER QUARTER SECTION CORNERS

98

| GOVERNMENT CORNERS No. | Bearing Trees | In. Dia. | Courses they bear | Links Distant | Bearing Trees | In. Dia. | Courses they bear | Links Distant | Bearing Trees | In. Dia. | Courses they bear | Links Distant | Bearing Trees | In. Dia. | Courses they bear | Links Distant |
|---|---|---|---|---|---|---|---|---|---|---|---|---|---|---|---|---|
| 1. N. W. Sec. Cor. indentified, | | | | | | | | | | | | | | | | |
| 2. N. E. Sec. Cor. indentified, | | | | | | | | | | | | | | | | |
| 3. S. E. Sec. Cor. indentified, | | | | | | | | | | | | | | | | |
| 4. S. W. Sec. Cor. indentified, | | | | | | | | | | | | | | | | |
| 5. N. ¼ Sec. Cor. indentified, | | | | | | | | | | | | | | | | |
| 6. E. ¼ Sec. Cor. indentified, | | | | | | | | | | | | | | | | |
| 7. S. ¼ Sec. Cor. indentified, | | | | | | | | | | | | | | | | |
| 8. W. ¼ Sec. Cor. indentified, | | | | | | | | | | | | | | | | |
| **Subdivision Corners** No. | | | | | | | | | | | | | | | | |
| 1. Center ¼ Sec. Cor. | | | | | | | | | | | | | | | | |
| 2. North ¼-⅛s N. W. qr., | | | | | | | | | | | | | | | | |
| 3. East ¼-⅛s N. W. qr., | | | | | | | | | | | | | | | | |
| 4. South ¼-⅛s N. W. qr., | | | | | | | | | | | | | | | | |
| 5. West ¼-⅛s N. W. qr., | | | | | | | | | | | | | | | | |
| 6. Center ¼-⅛s N. W. qr., | | | | | | | | | | | | | | | | |
| 7. North ¼-⅛s N. E. qr., | | | | | | | | | | | | | | | | |
| 8. East ¼-⅛s N. E. qr., | | | | | | | | | | | | | | | | |
| 9. South ¼-⅛s N. E. qr., | | | | | | | | | | | | | | | | |
| 10. Center ¼-⅛s N. E. qr., | | | | | | | | | | | | | | | | |
| 11. East ¼-⅛s S. E. qr., | | | | | | | | | | | | | | | | |
| 12. South ¼-⅛s S. E. qr., | | | | | | | | | | | | | | | | |
| 13. West ¼-⅛s S. E. qr., | | | | | | | | | | | | | | | | |
| 14. Center ¼-⅛s S. E. qr., | | | | | | | | | | | | | | | | |
| 15. South ¼-⅛s S. W. qr., | | | | | | | | | | | | | | | | |
| 16. West ¼-⅛s S. W. qr., | | | | | | | | | | | | | | | | |
| 17. Center ¼-⅛s S. W. qr. | | | | | | | | | | | | | | | | |

N. C. MILLER CO. MFG. STATIONERS, MILWAUKEE X15000




Surveyed by W. M. Child CS

NAMES OF SWORN ASSISTANTS

CHAINMEN

FLAGMEN


AXMEN

Recorded by Floyd F. Jensen CS.

Feb. 27, 1934

98

No 308

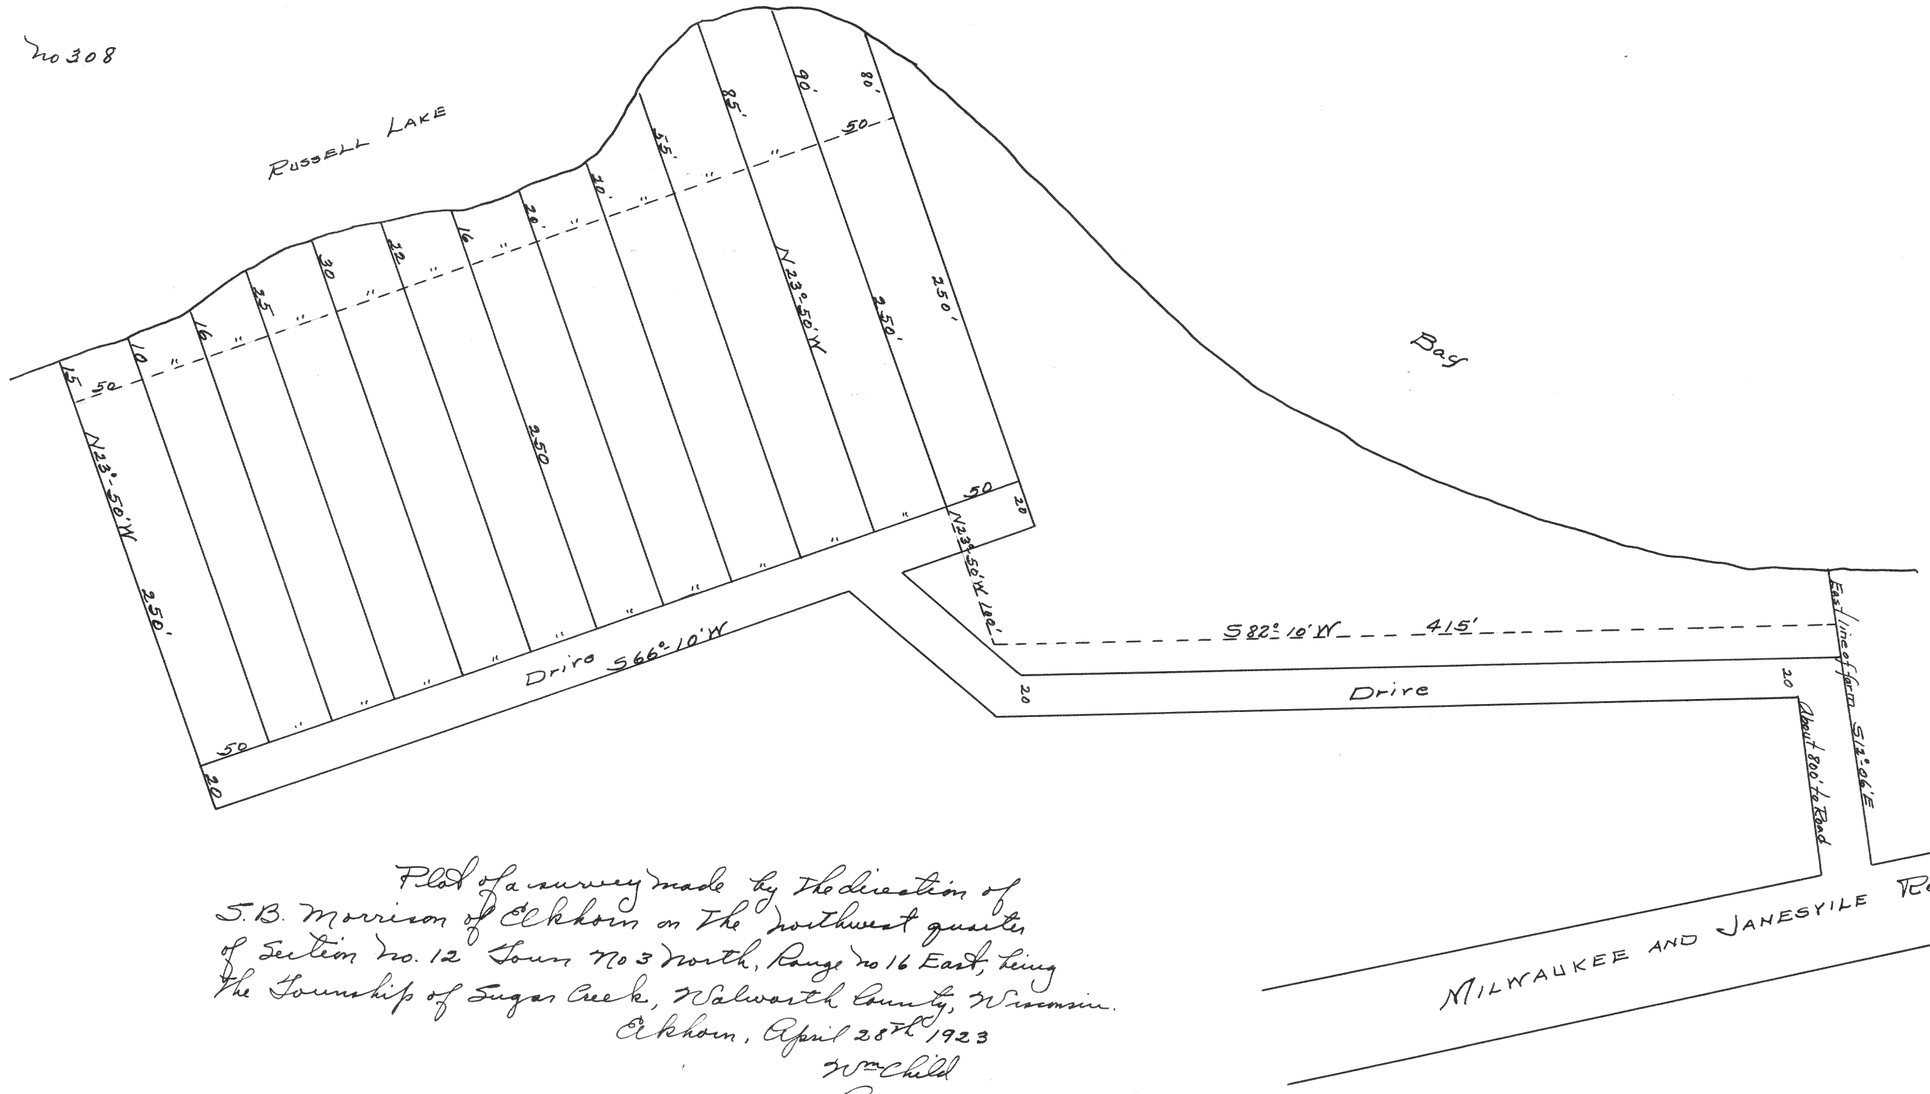


Plat of a survey made by the direction of S.B. Morrison of Elkhorn on the northwest quarter of Section No. 12 Town No 3 North, Range No 16 East, being the Township of Sugar Creek, Walworth County, Wisconsin.

Elkhorn, April 28th 1923

W^m Child

County Surveyor.

Recorded by Lloyd S. Jones Co.
Feb. 28, 1934