1915

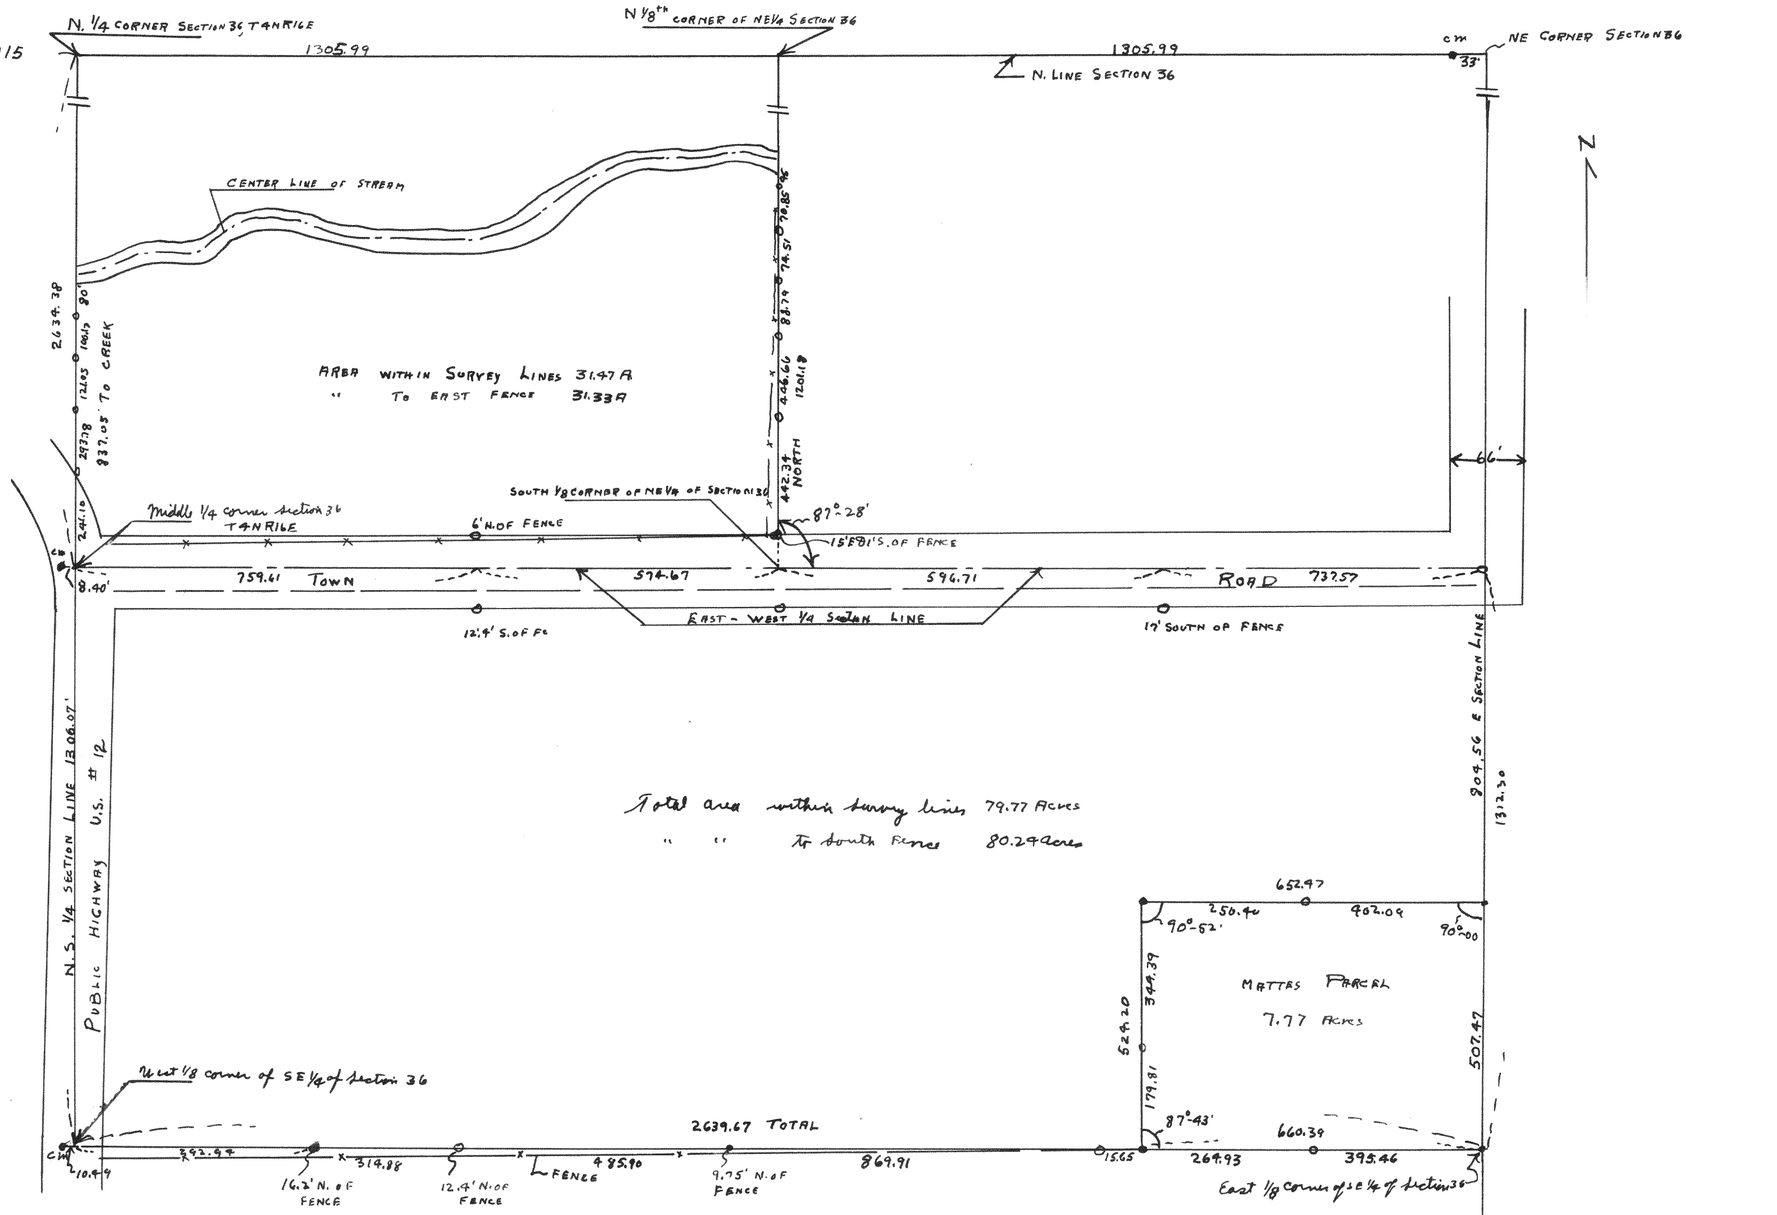

Plat of survey of the Charles Dunbar Farm located in Section 36 T4N R16E of Woodworth County Miss
Sept 1998

Lloyd S Jensen
County Surveyor