#1943

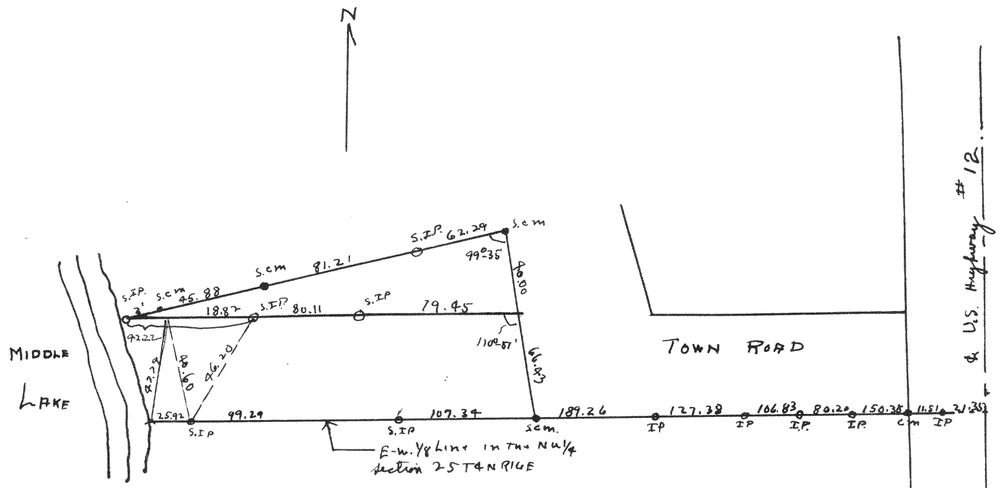

Plat of survey of the N Line of Ruby area West of Highway #12 and the parcel of land purchased from Lauderdale, located in the NW¼ of Section 25 T4N R16E Walworth County Wisconsin

1998

Lloyd S Jensen
County Surveyor

#1944

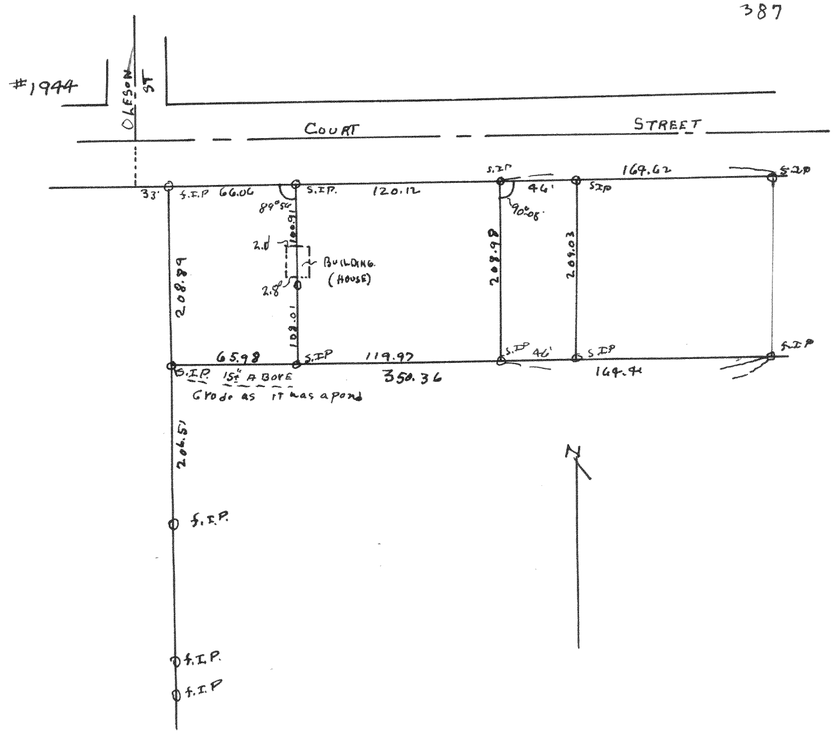

Plat of survey of parcels of land located in the City of Elkhorn

March 27 1998

Lloyd S Jensen
County Surveyor