#2277

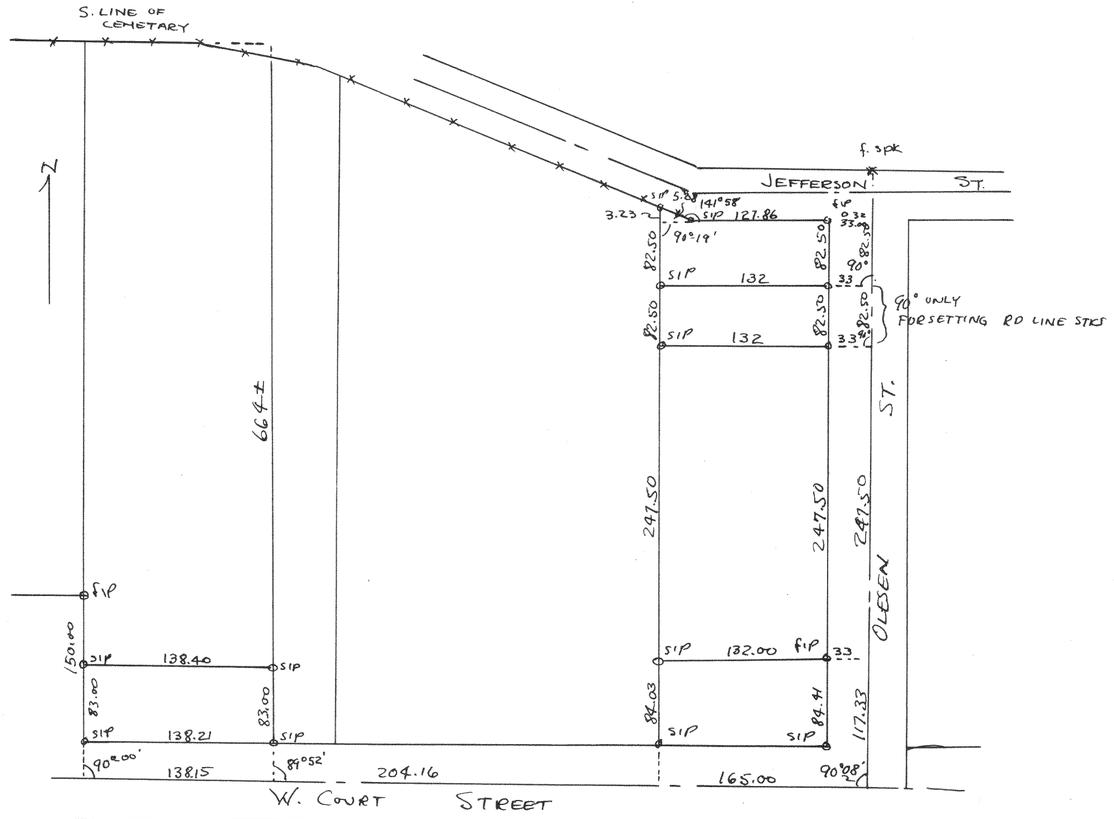

Plat of survey of parcels of land for Karavoskis located in the City of Elkhorn, Walworth County, Wisconsin
July 25, 1950

Lloyd T. Jensen
County Surveyor

2278

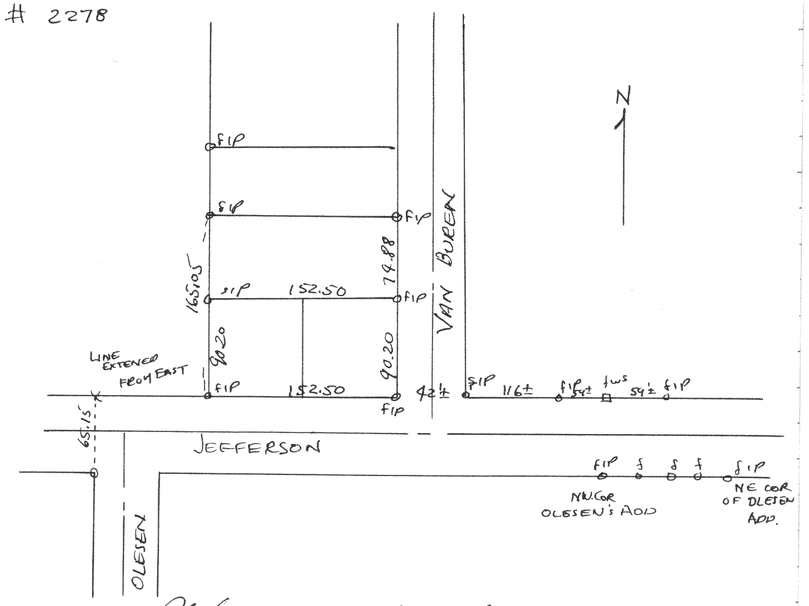

Plat of survey of Cooper land located in SE¼ Sec 36 T3N R16E City of Elkhorn, Walworth County, Wis.
July 25, 1950

Lloyd T. Jensen
County Surveyor