
#1355

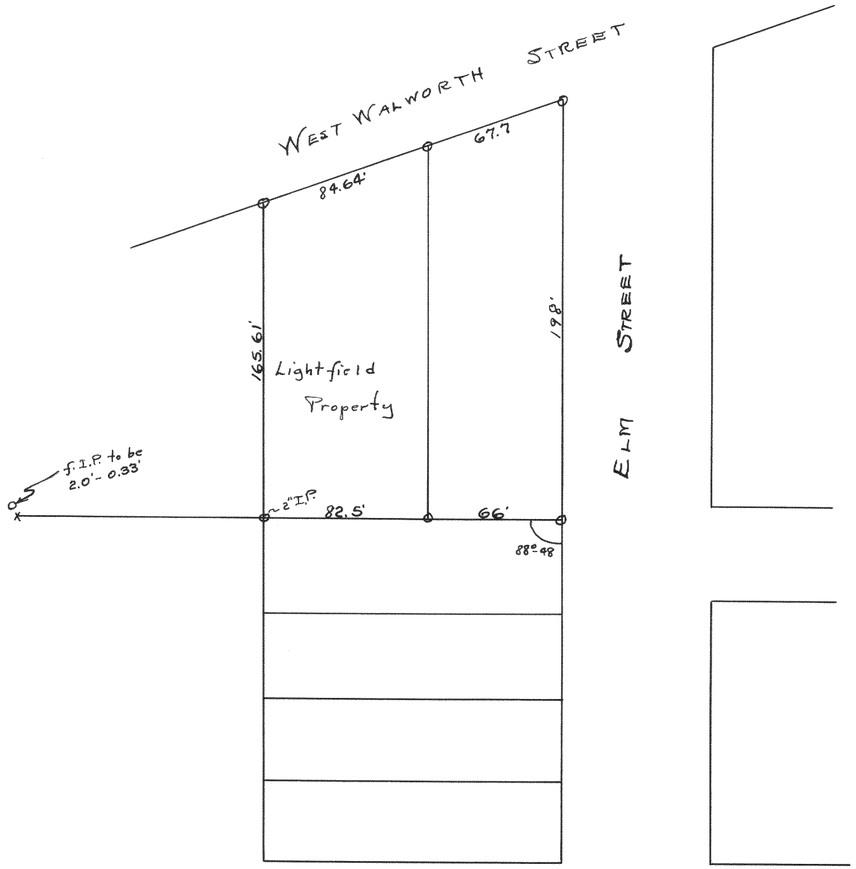


Plat of survey of Lightfield property in the City of Elkhorn, Wisconsin.

May 1942

Lloyd L. Jensen
County Surveyor

#1356

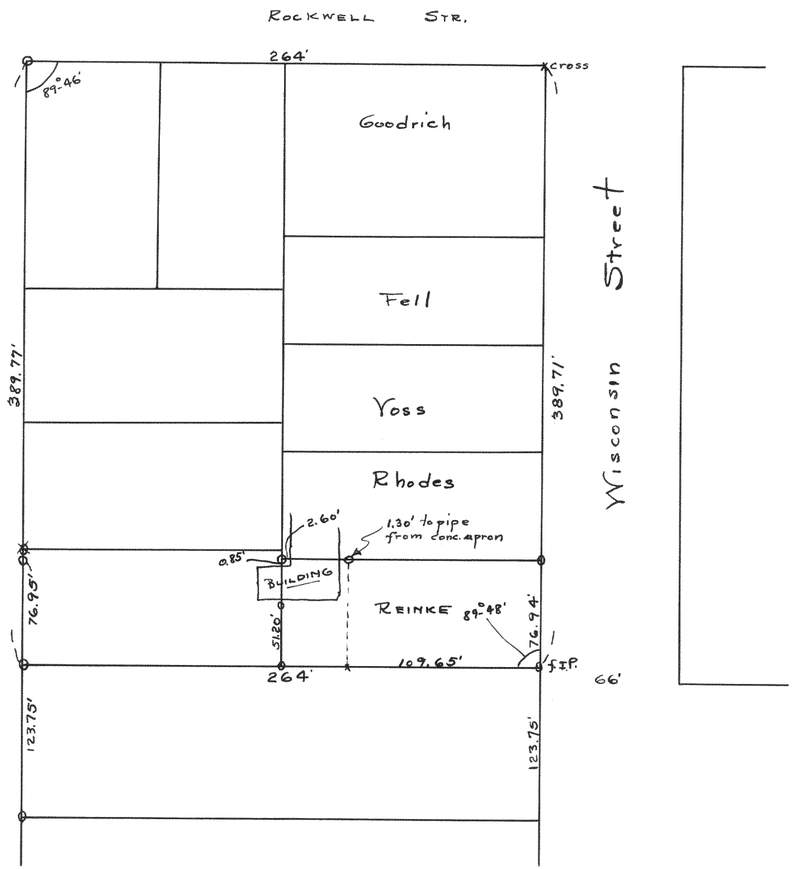

Plat of survey of Reinke property in the City of Elkhorn, Wisconsin.

April 1942

Lloyd L. Jensen
County Surveyor