

#1359

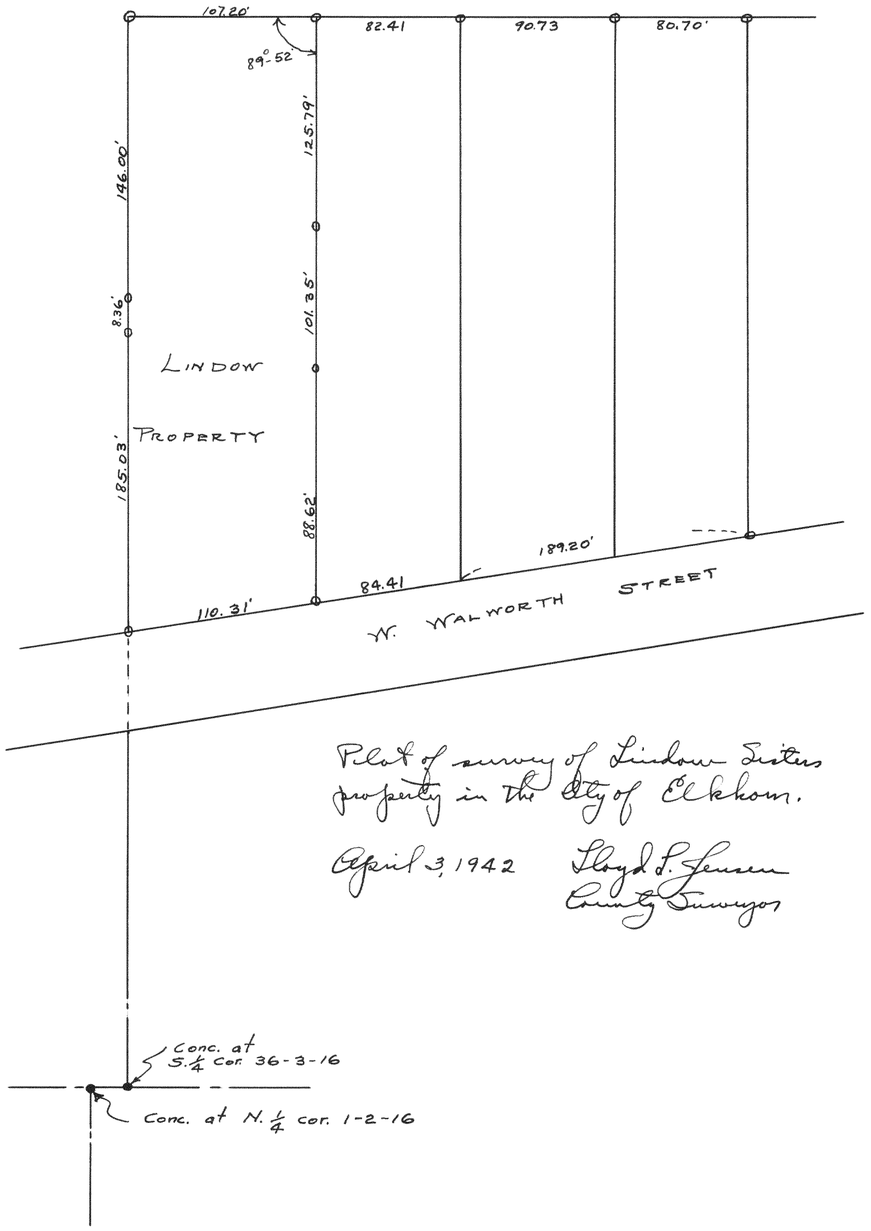

Plat of survey of Lindow Sisters property in the City of Elkhorn.

April 3, 1942 Lloyd L. Jensen
County Surveyor

#1360

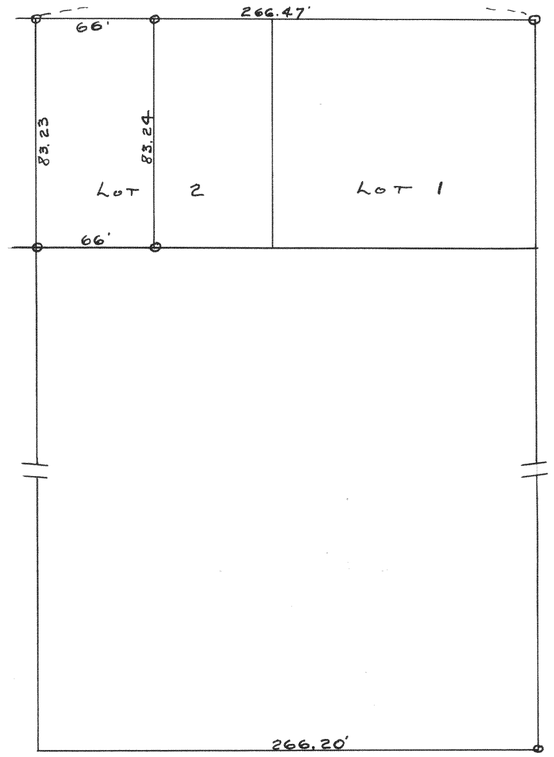

Plat of survey of the West 66 feet of Lot 2 of Block 18 of the original plat of the City of Elkhorn, Wisconsin.

May 1942 Lloyd L. Jensen
County Surveyor