
#1365

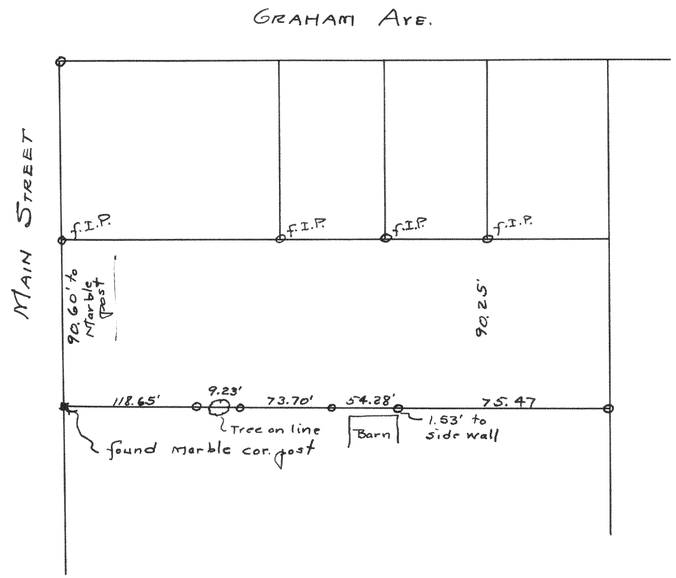


Plat of survey of the West line of the Horgum property in the City of Williams.

July 1942

Floyd L. Jensen
County Surveyor.

#1366

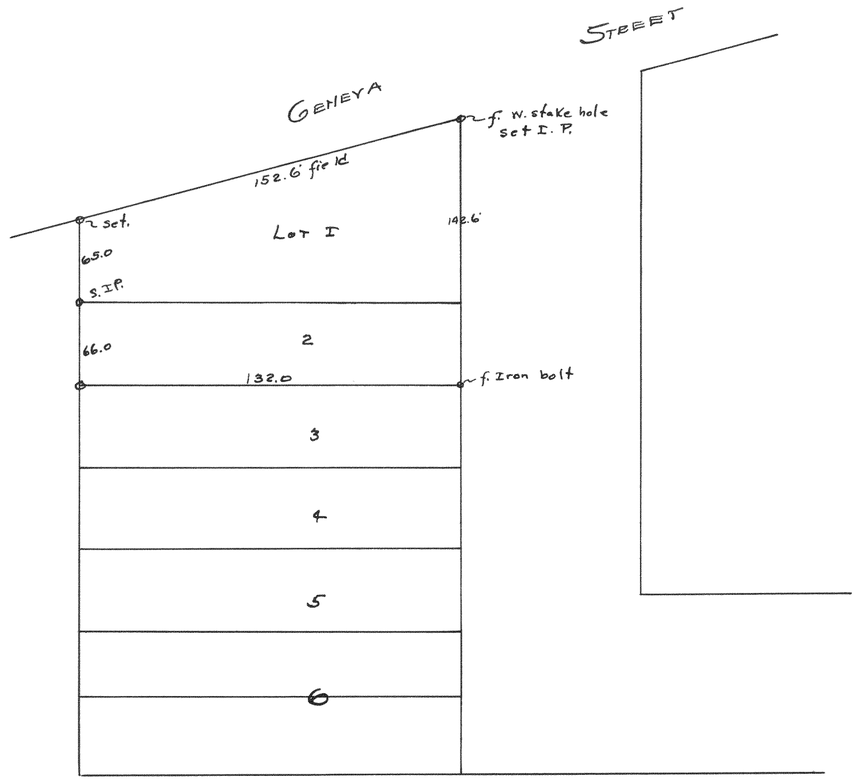

Plat of survey of the rear line of Lot 2 of Blk. 5 of the original plat of Williams Bay Wisconsin.

Nov. 1942

Floyd L. Jensen
County Surveyor