
#1369

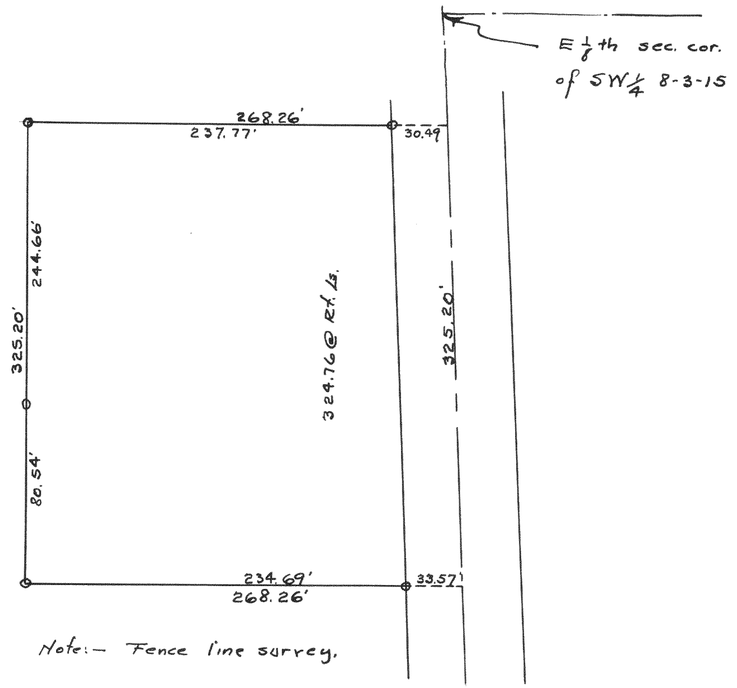


Plat of survey of land located in Section 8, T5N R15E of Walworth County.

Oct. 16, 1942

Lloyd L. Jensen
County Surveyor

#1370

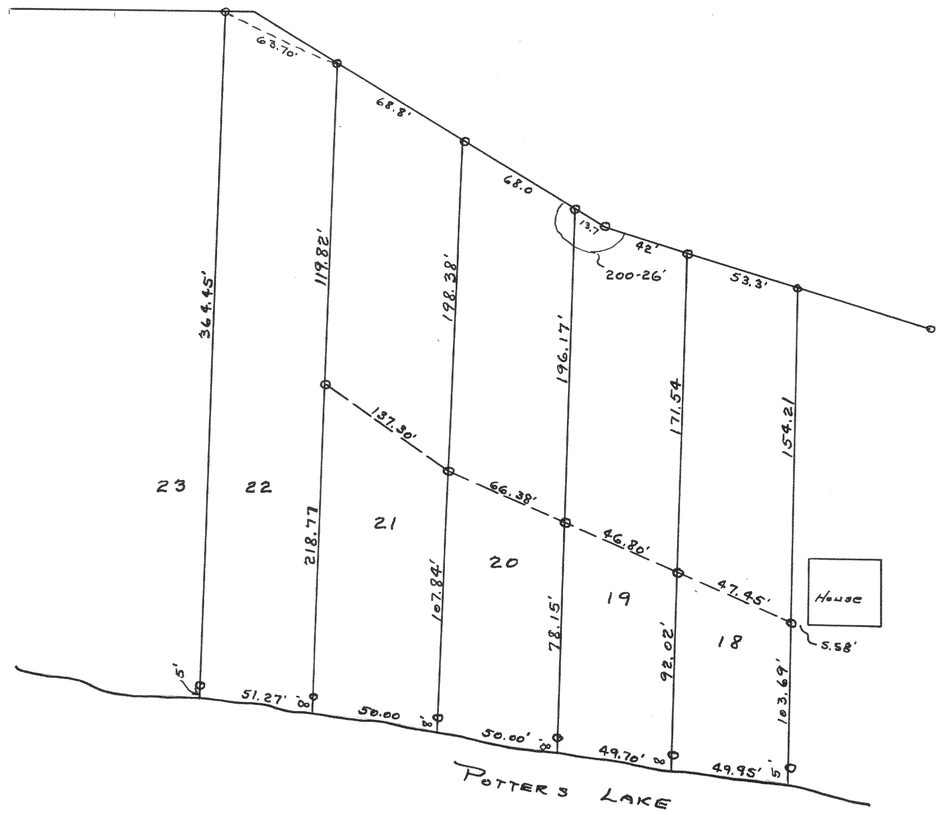

Plat of survey of lots 18 to 21 incl. of Block 1 of Miramar Subd.

Aug. 1942

Lloyd L. Jensen
County Surveyor