
Part of #1372 including the Survey 7-4-43


#1371

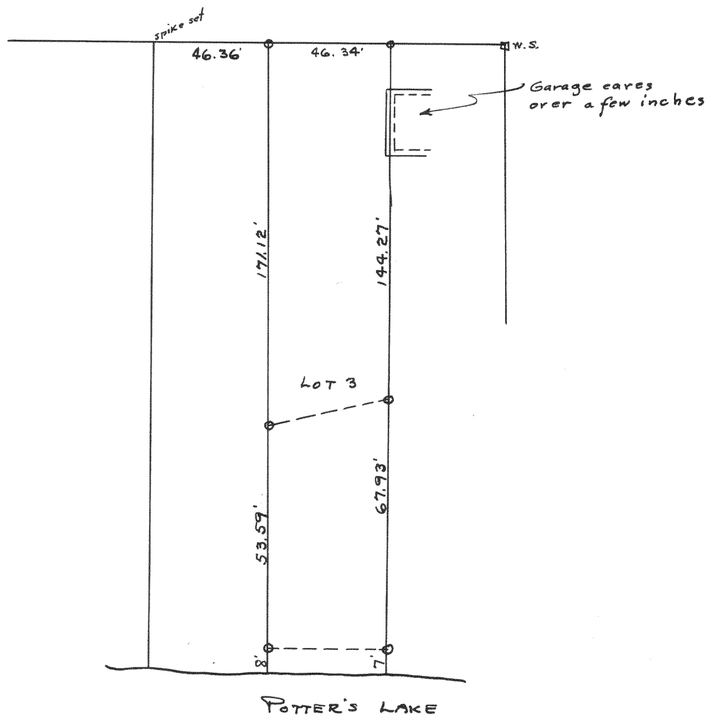

Plat of survey of Lot 3 of Block I of Miramar Subd.

July 1942 — Lloyd S. Jensen, County Surveyor

#1372

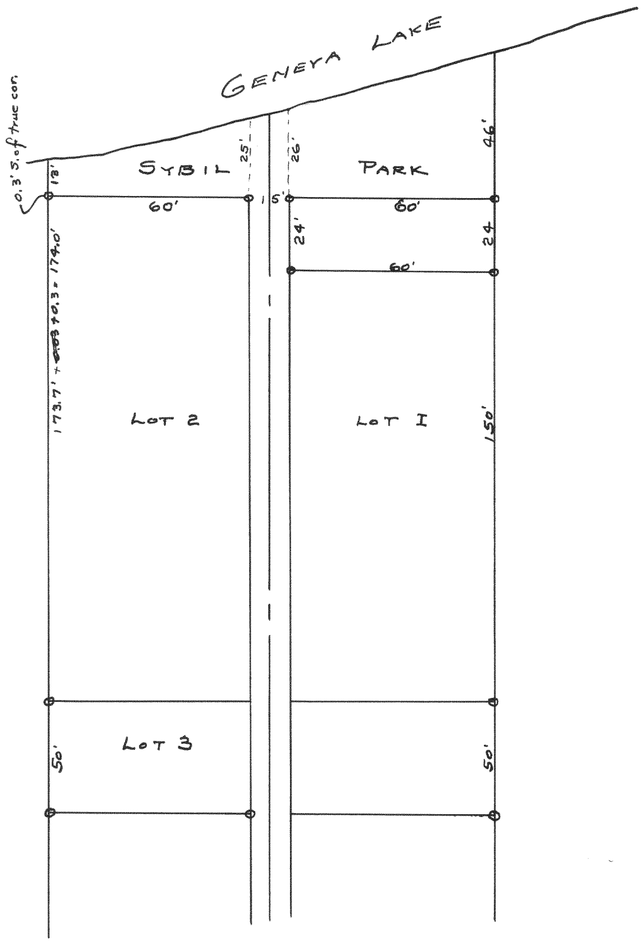

Plat of survey of Lot 2 and 3 and the North 24 feet of Lot 1 of Camp Sybil Subdivision.

June 1, 1942 — Lloyd S. Jensen, County Surveyor