
#1373

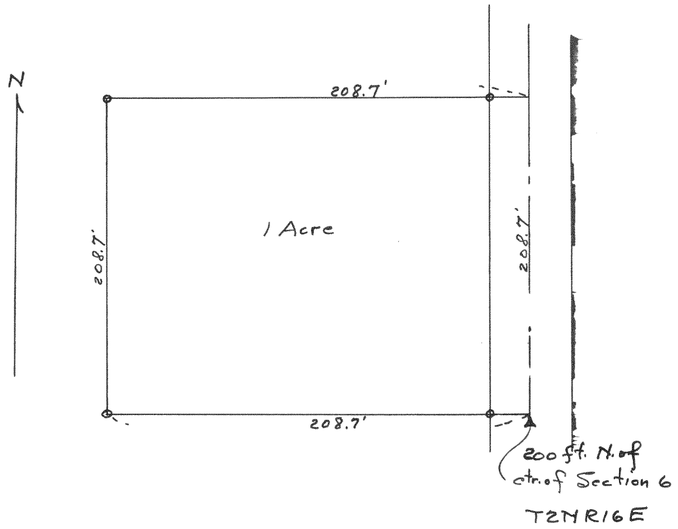


Survey of 1 acre parcel of land in the Southeast corner of SE¼ of NW¼ of Section 6-2-16

March 16, 1943

Lloyd L. Jensen
County Surveyor

#1374

PUBLIC ROAD

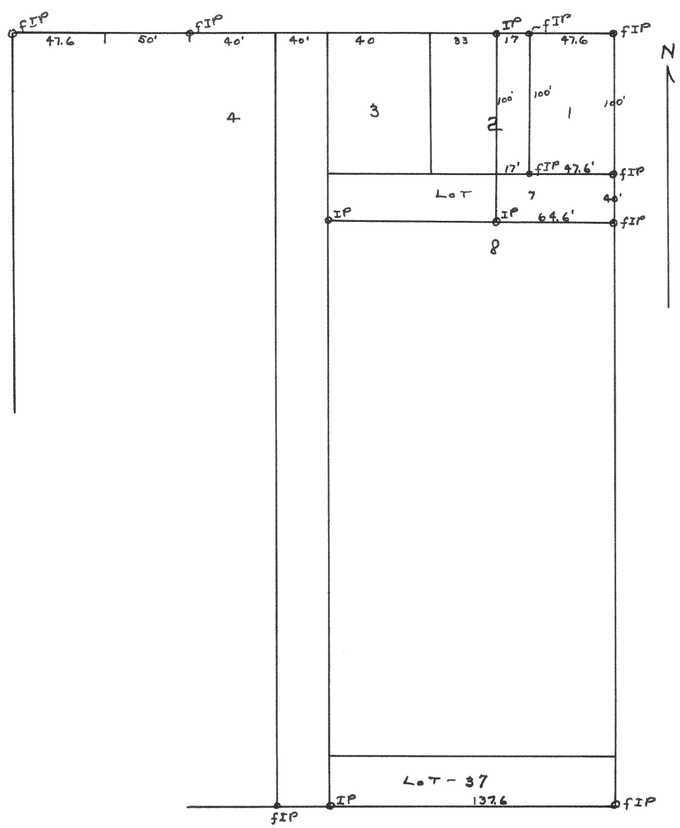

Plat of survey of Lots 1, E. 17' of 2, E 64.6' of 7 and all of Lots 8 to 37 inclusive of Paradise Vista Subd. Sec. 1-1-17

Mar. 28, 1943

Lloyd L. Jensen
County Surveyor