

#1375

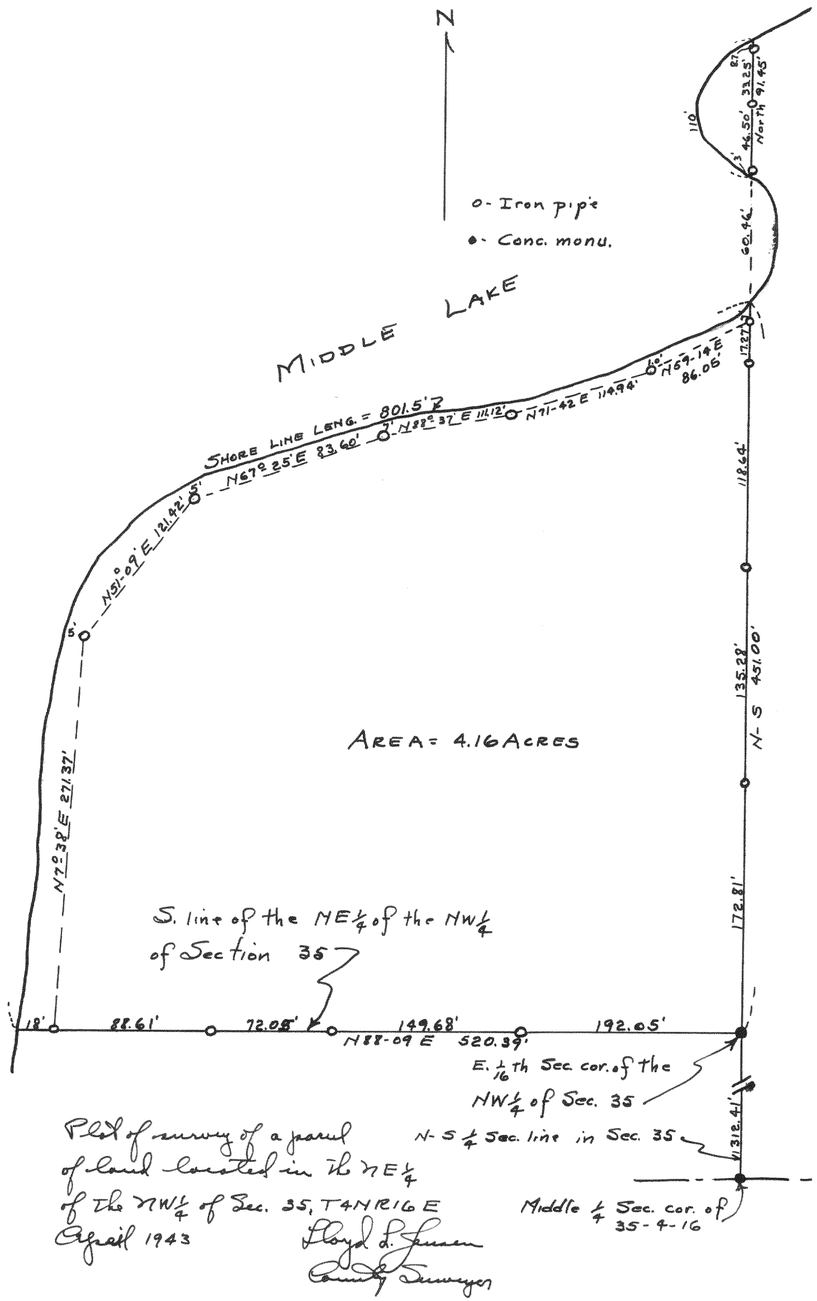

Plat of survey of a parcel of land located in the NE¼ of the NW¼ of Sec. 35, T4NR16E
April 1943

Lloyd L. Jensen
County Surveyor

#1376

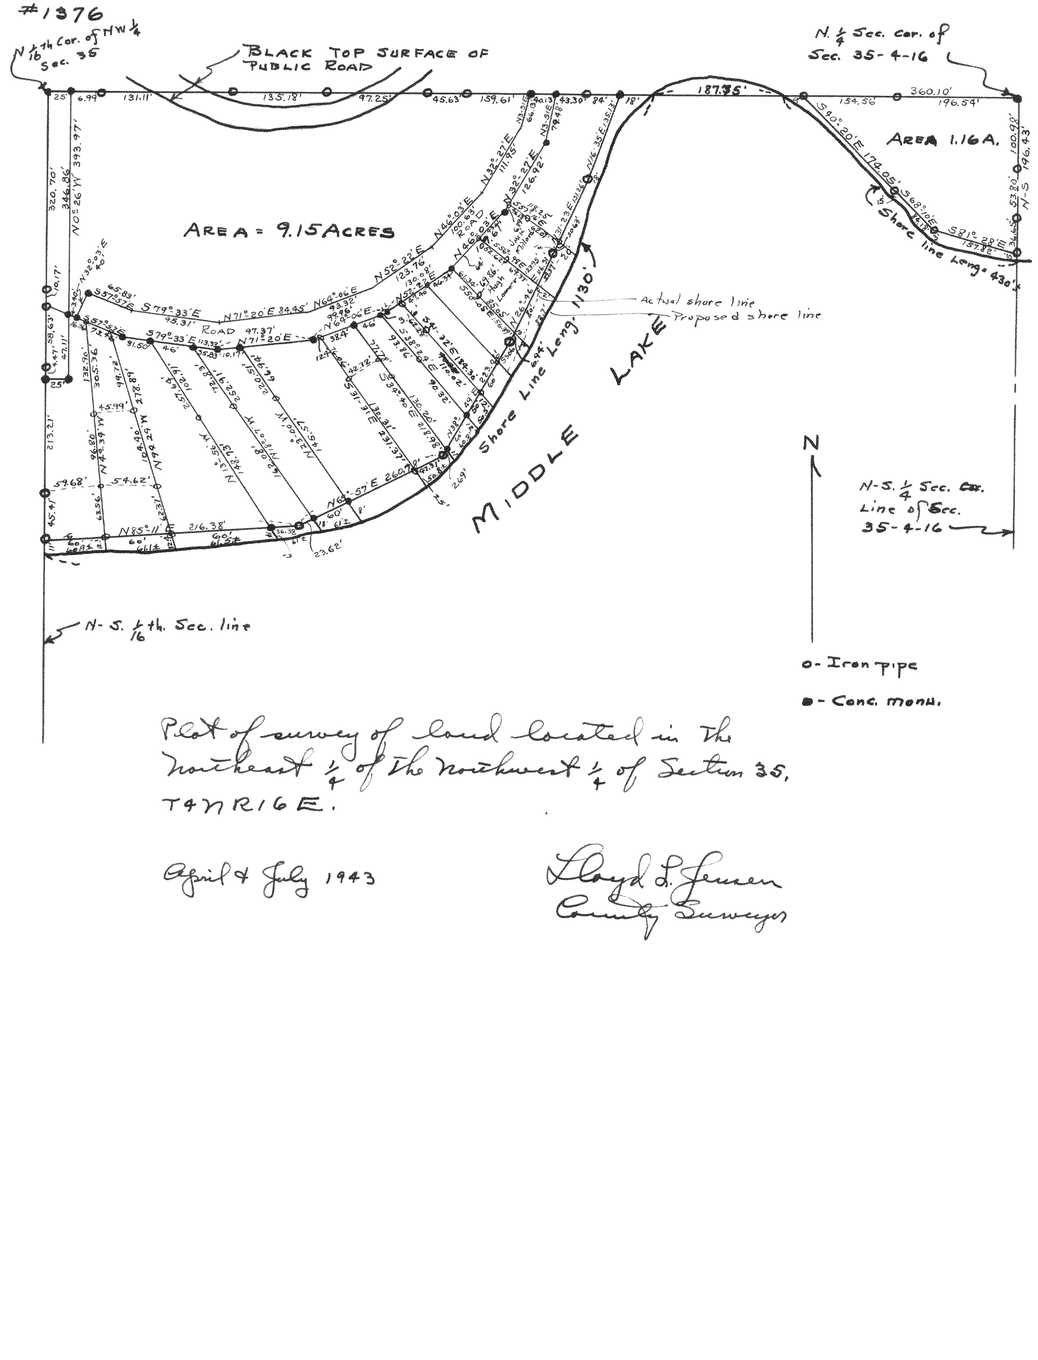

Plat of survey of land located in the Northeast ¼ of the Northwest ¼ of Section 35, T4NR16E.

April & July 1943

Lloyd L. Jensen
County Surveyor