
#1379

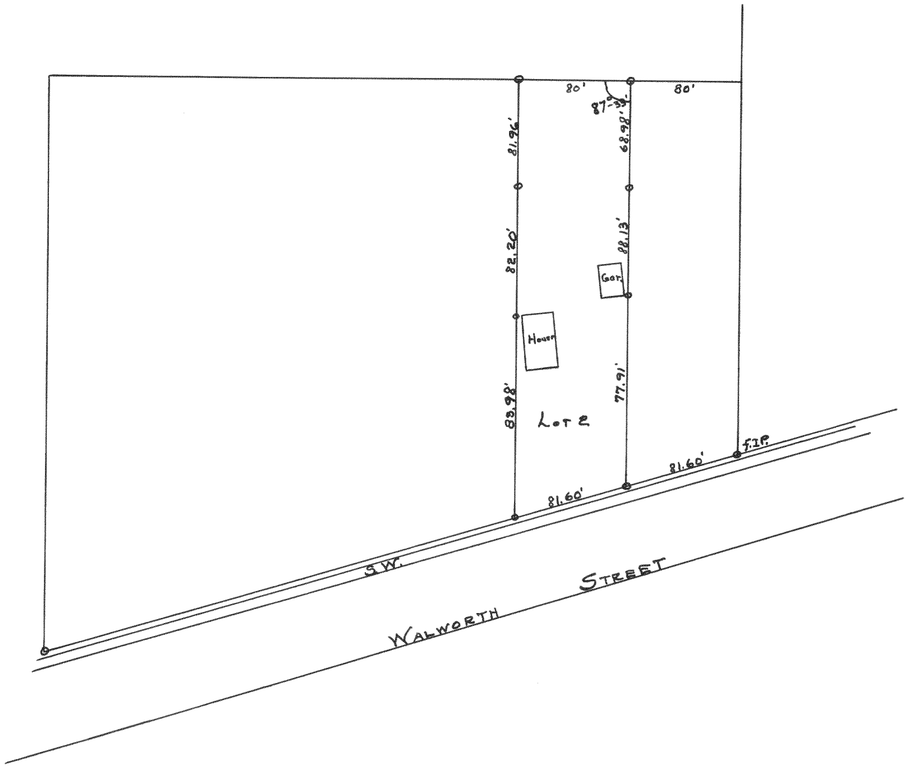


Plat of survey of Lot 2 of Alicia Ogden's Subd. in the City of Elkhorn, Wis.

Sept. 26, 1943

Lloyd L. Jensen
County Surveyor

#1380

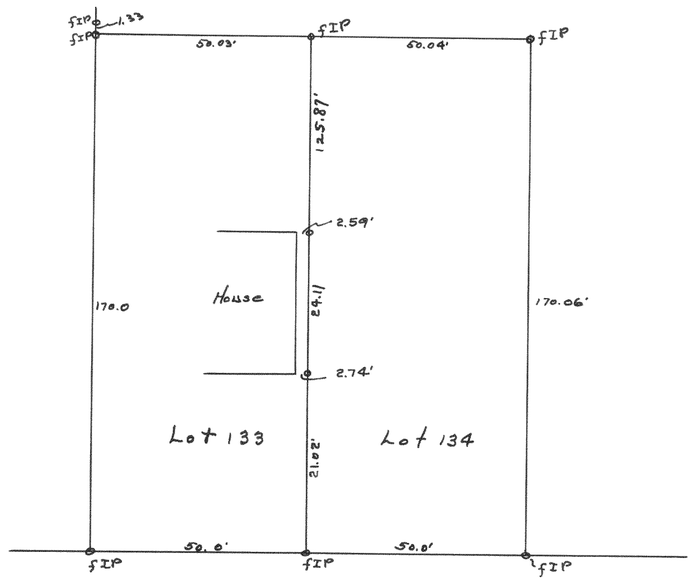

Road

Plat of survey of Lot 133 of Lake Geneva Beach Subd. in Section 11, T1N R17E.

July 29, 1943

Lloyd L. Jensen
County Surveyor