
#1382

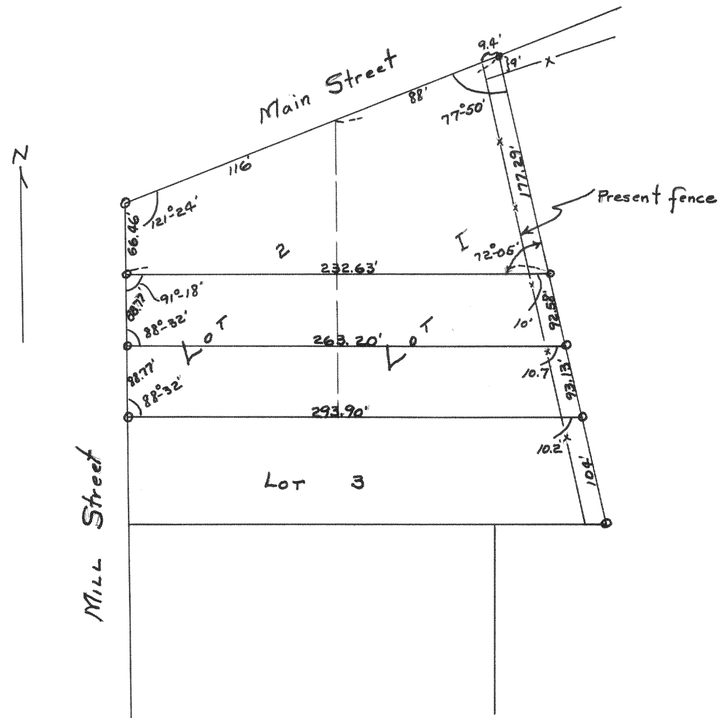


Plat of survey of the Subd. of Lots 182 of Blk 13 of the Original Plat of the Village of East Troy.

May 1943

Floyd L. Jensen
County Surveyor

#1383

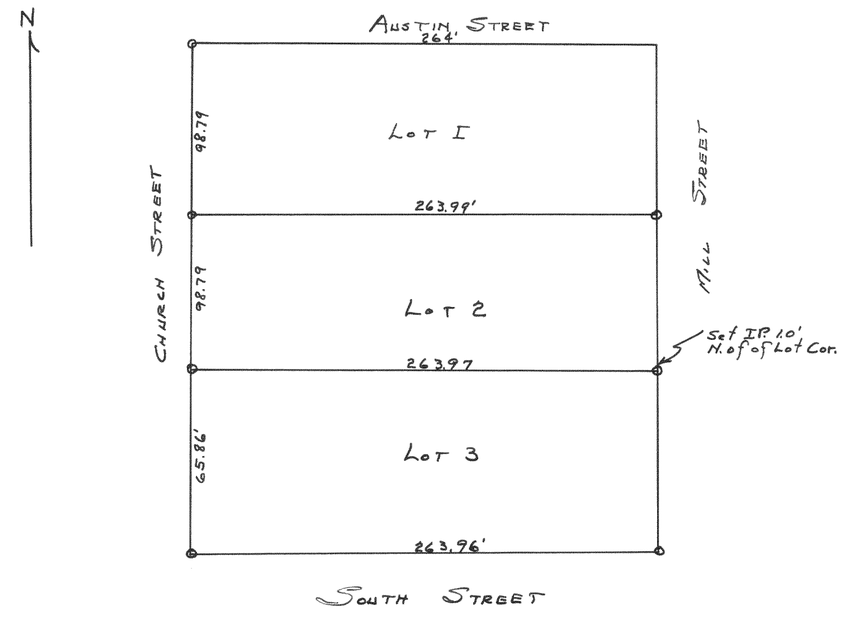

Plat of survey of Lot 2 of Blk. 15 of the Original Plat of the Village of East Troy Wis.

Aug. 1943

Floyd L. Jensen
County Surveyor