

#1384

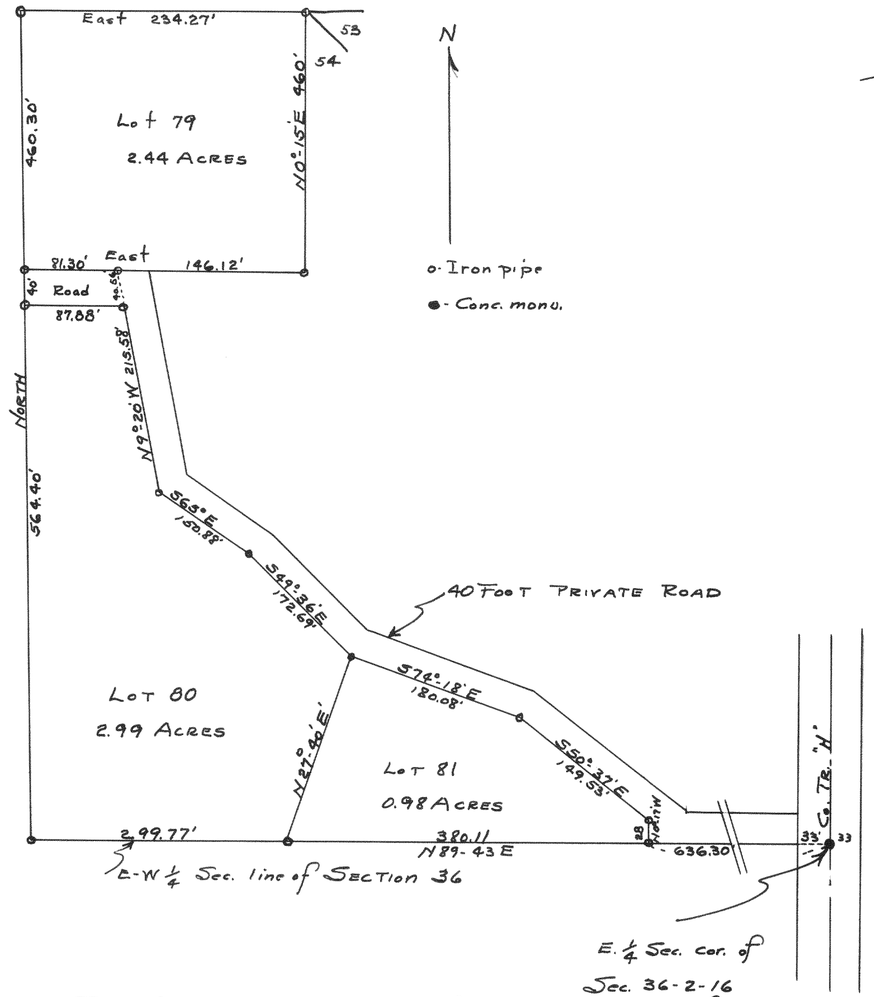

Plat of survey of land located in the East 1/2 of the Northeast 1/4 of Section 36, T2NR16E.
June 1943

Lloyd A. Jensen
County Surveyor

#1385

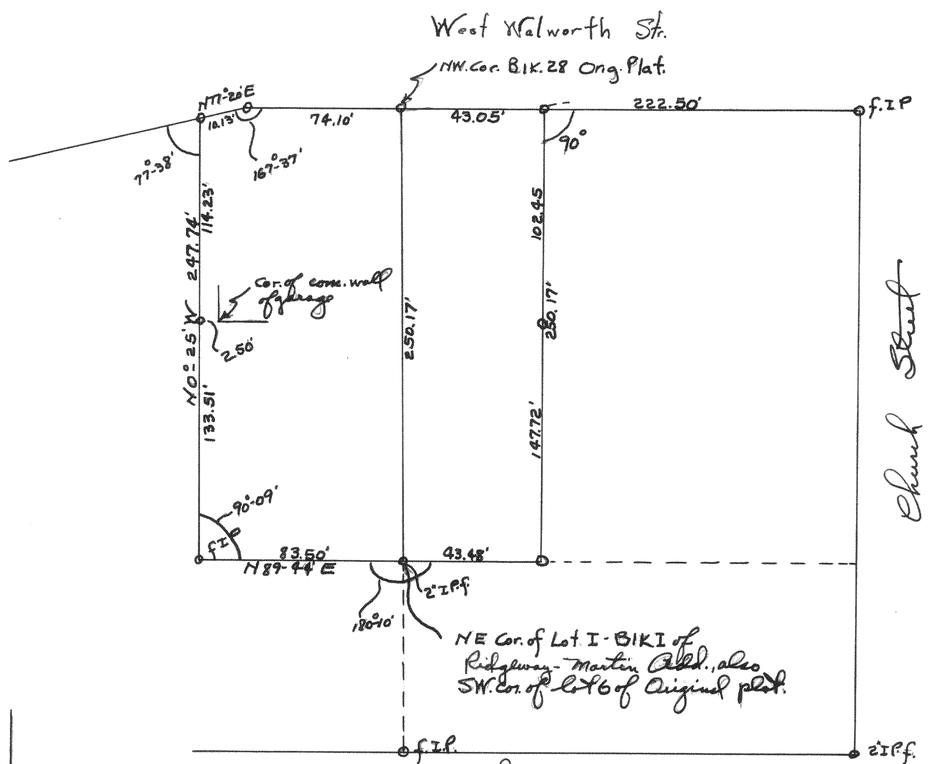

Plat of survey of the Hon Matheson property on West Walworth Street in the City of Elkhorn,
June 6, 1943

Lloyd A. Jensen
County Surveyor