
#1393

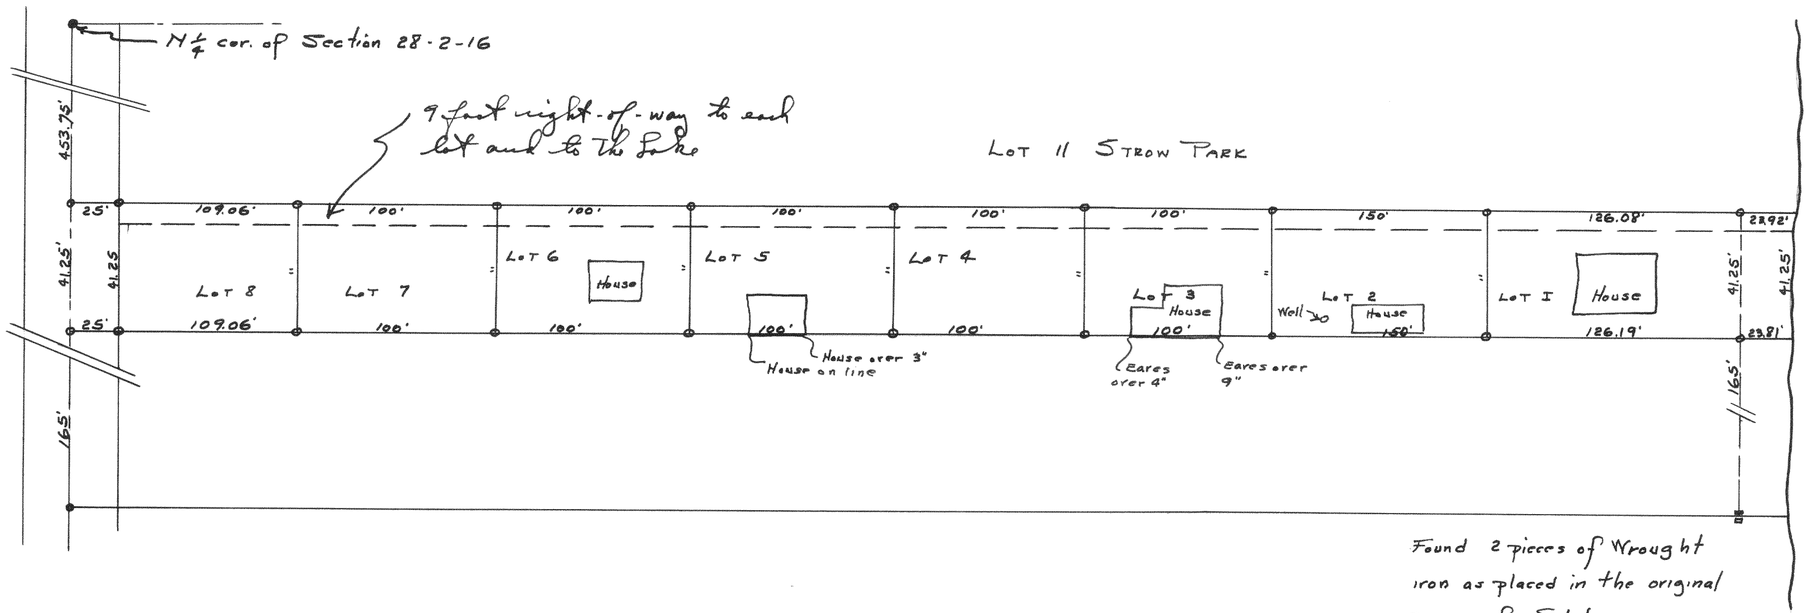

Survey of Lot 12 of Strow Park and dividing of it into 8 lots.

July 1943

Lloyd L. Jensen
County Surveyor