
#1394

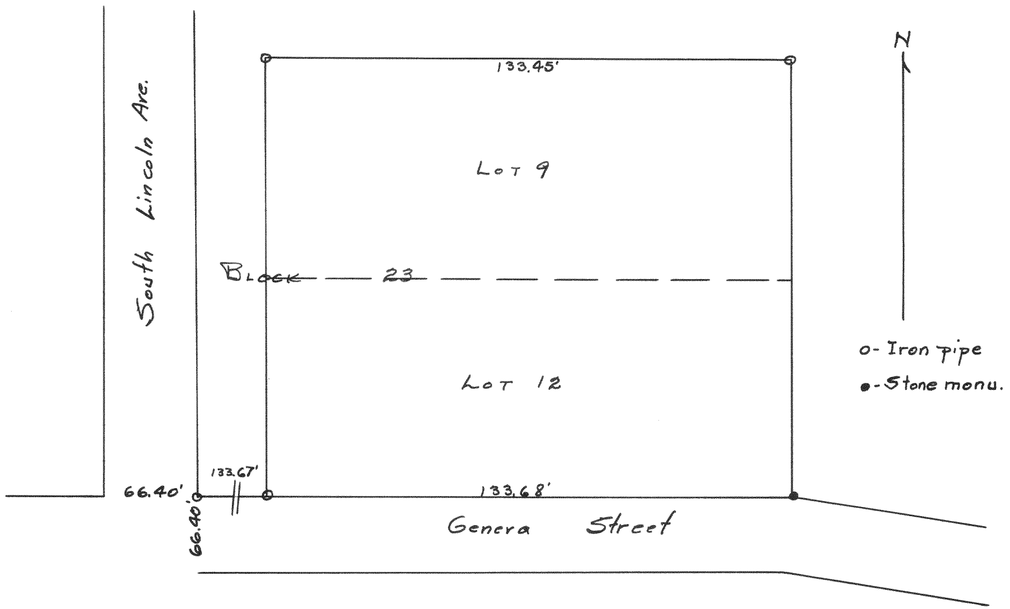


Plat of survey of Lots 9 and 12 of Block 23 of Rockwell's Add. to City of Elkhorn.

June 1943

Lloyd L. Jensen
County Surveyor

#1395

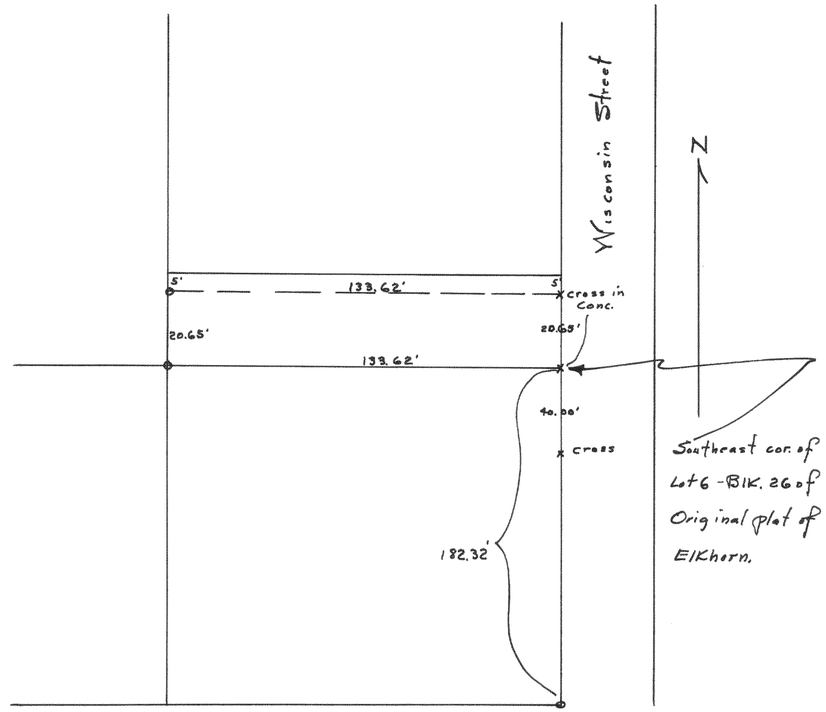

Plat of survey of part of Lot 6 of Blk. 26 of Original plat of City of Elkhorn.

May 27, 1943

Lloyd L. Jensen
County Surveyor