
#1402

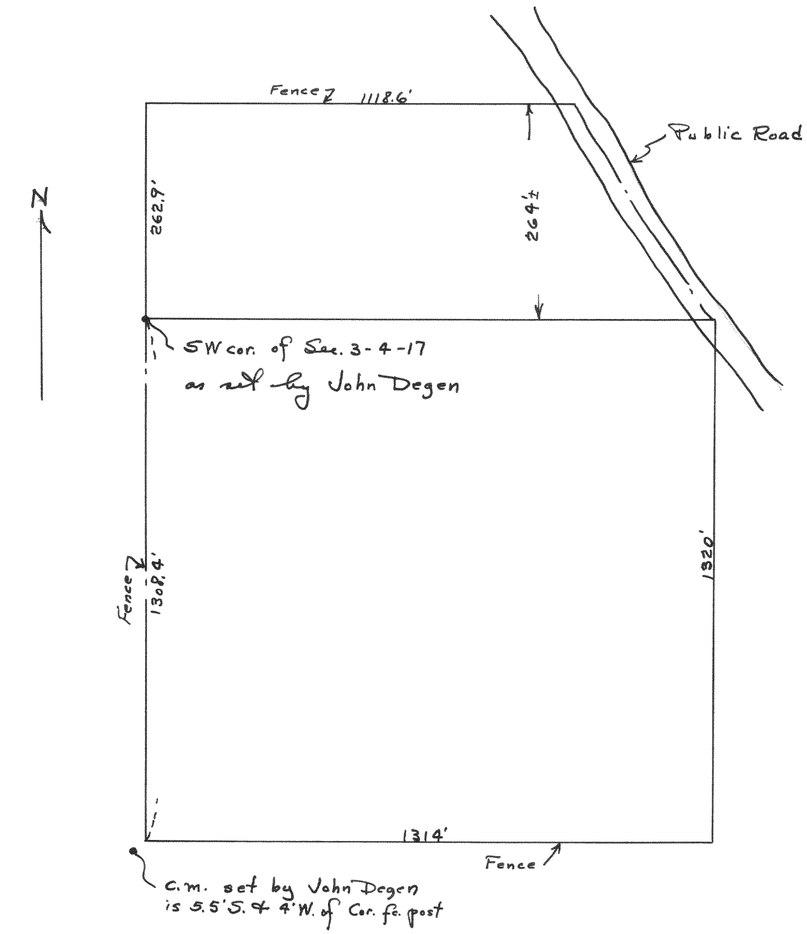


Plat of survey of fence lines of a farm located in Sections 3 and 10 of T4N R17E.

April 20, 1943

Lloyd L. Jensen
County Surveyor

#1403

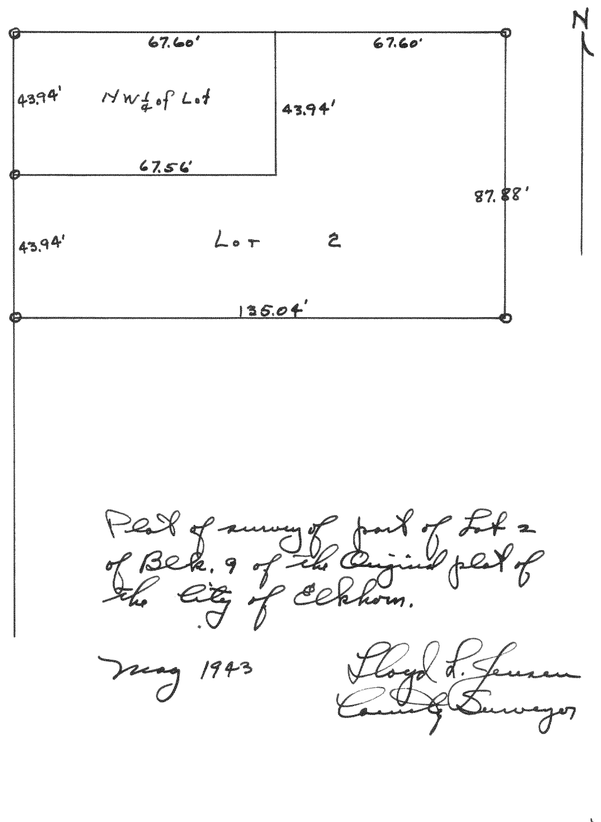

Plat of survey of part of Lot 2 of Blk. 9 of the Original plat of the City of Elkhorn.

May 1943

Lloyd L. Jensen
County Surveyor