

#1407

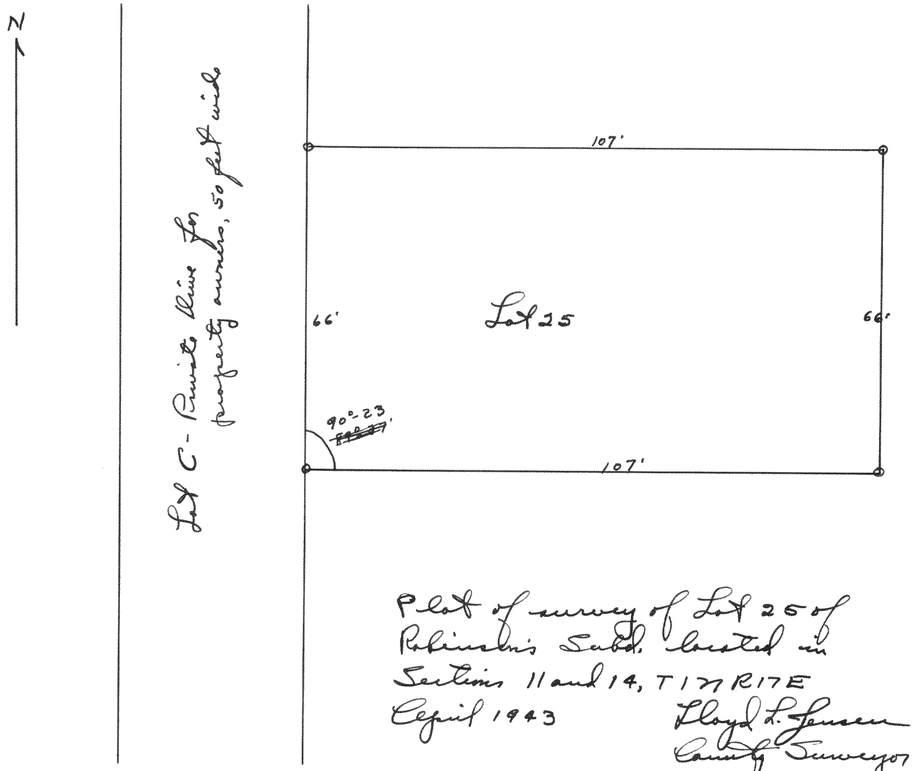

Plat of survey of Lot 25 of Robinette's Subd. located in Sections 11 and 14, T 17 R 17 E
April 1943

Floyd S. Jensen
County Surveyor

#1408

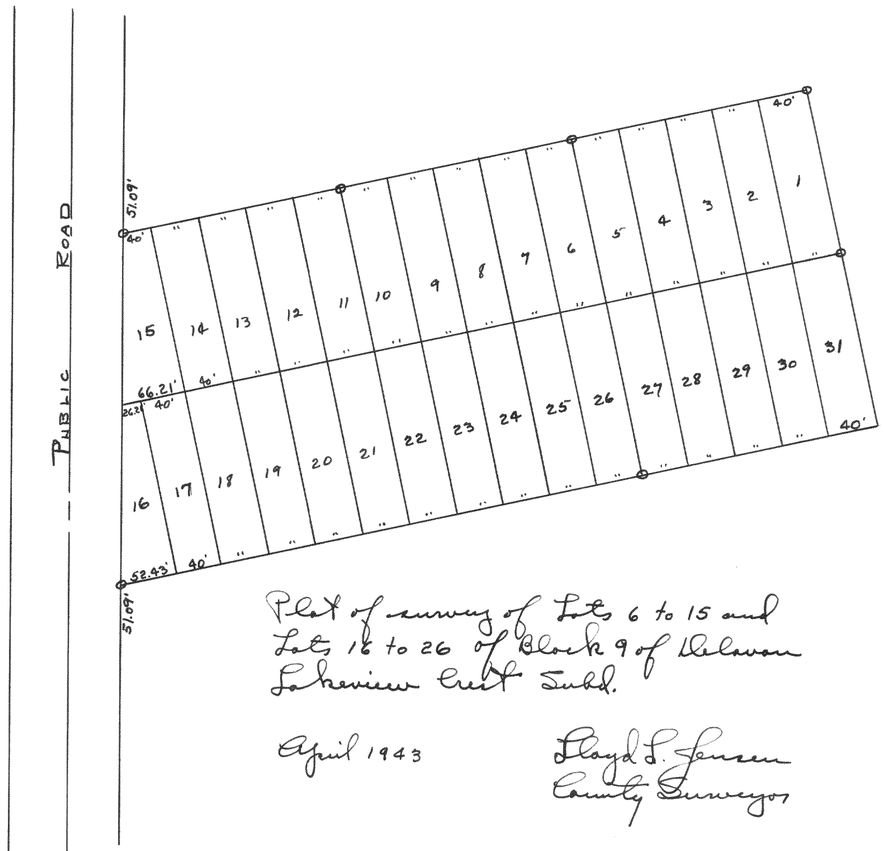


April 1943

Floyd S. Jensen
County Surveyor