
#1411

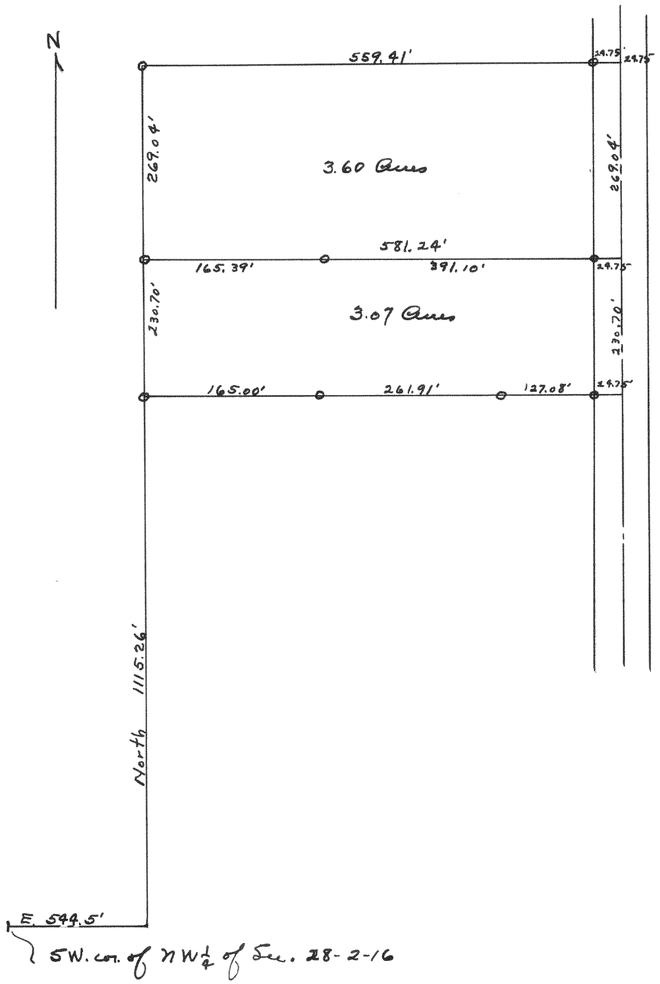


SW. cor. of NW¼ of Sec. 28-2-16

Plat of survey of 2 parcels of land in Section 28 for James Dowling.

May 1943

Lloyd L. Jensen
County Surveyor

#1412

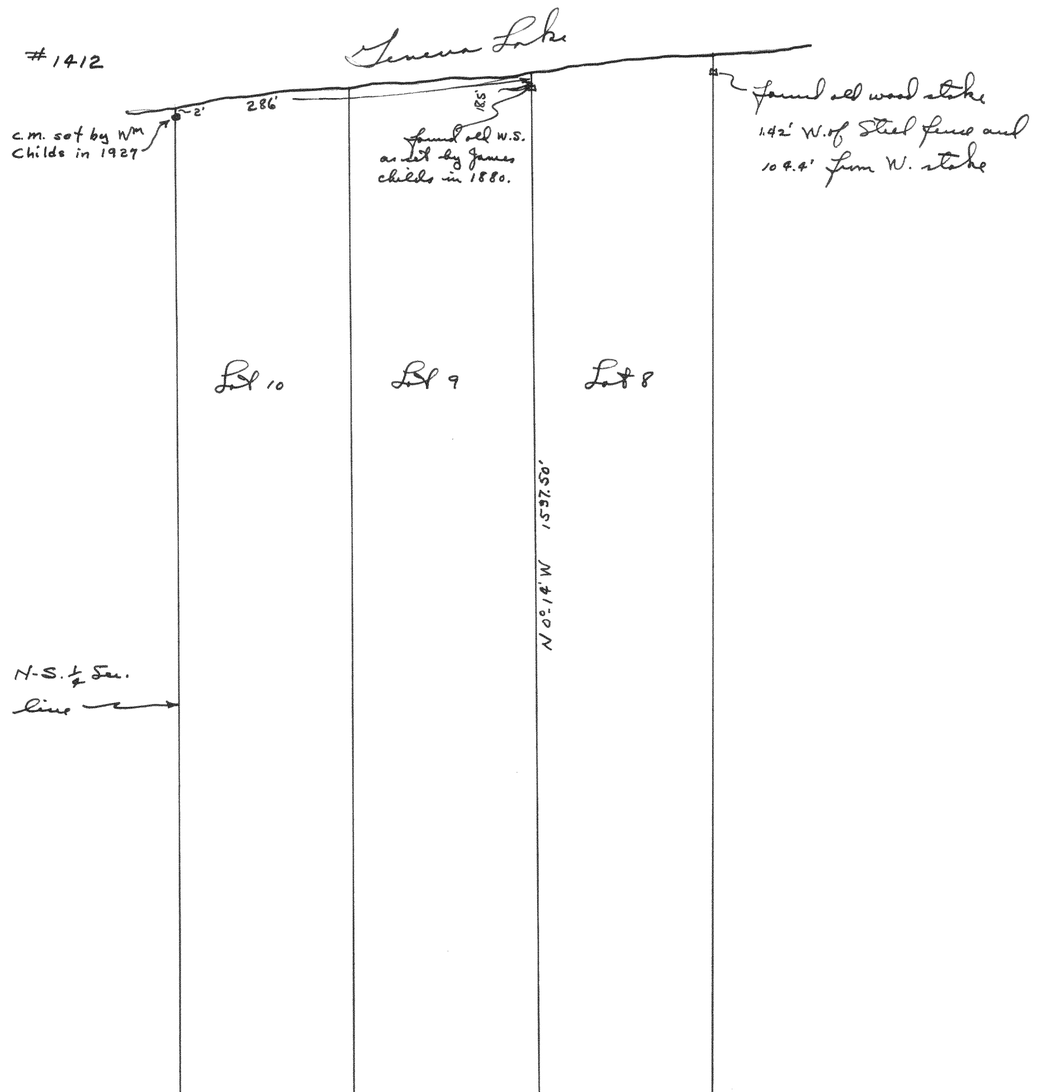

Plat of survey of the lines between Lots 8 and 9 of the unrecorded plat of Government Lot 2 of Section 18 T1N R17E

Dec. 1943

Lloyd L. Jensen
County Surveyor