
#1413

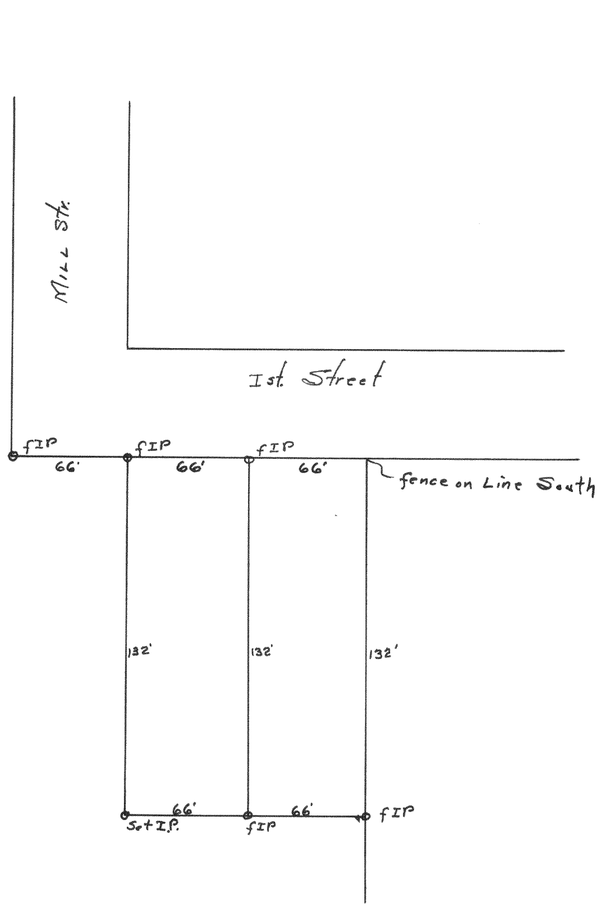


Plat of survey of 2 parcels of land located in Section 35, Village of Genoa City.

Jan. 12, 1943

Lloyd P. Jensen
County Surveyor

#1414

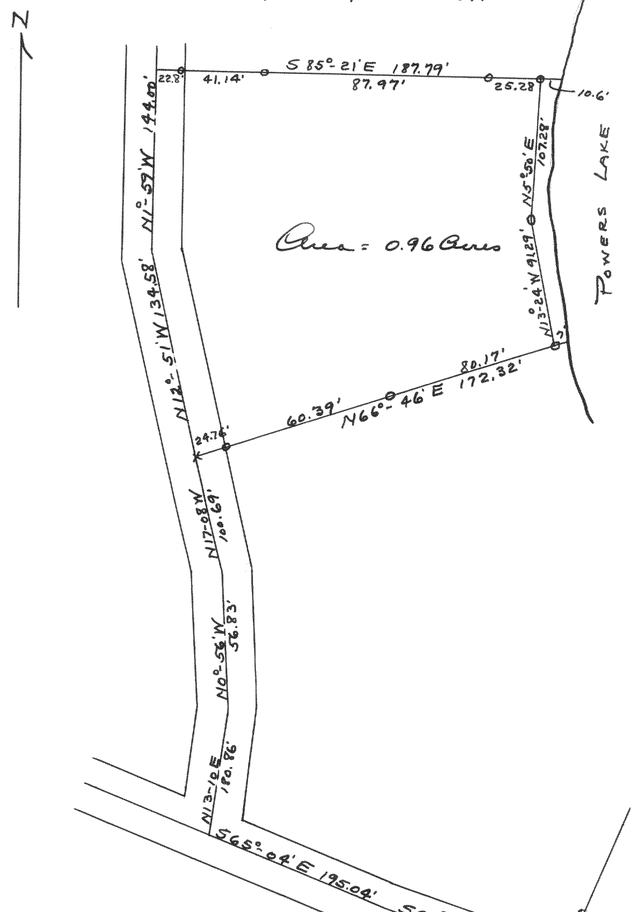

Plat of survey of Ballas Est. in Section 13, T1N R18E.

Dec. 1943

Lloyd P. Jensen
County Surveyor.