
#1418

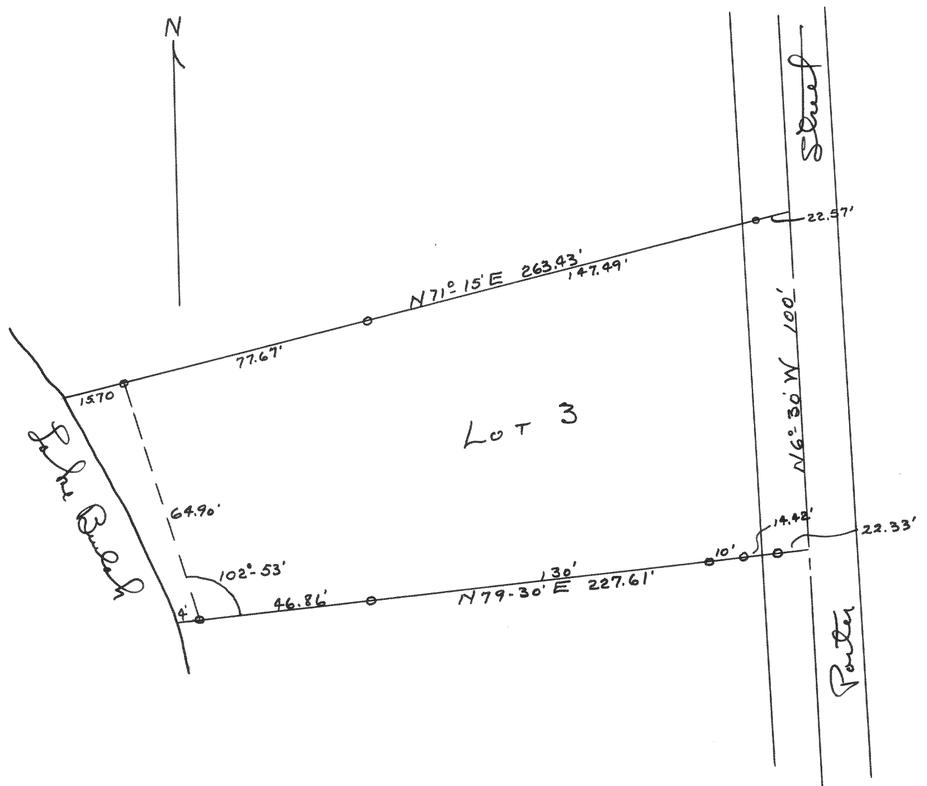


Plat of survey of Lot 3 of Block 2 of Freed Park, Section 4, T47N R18E.

Nov. 1943

Lloyd L. Jensen
County Surveyor

#1419

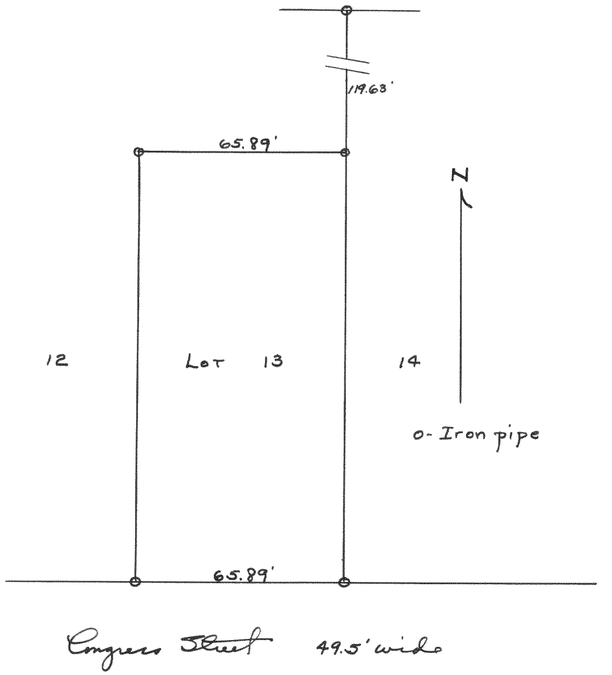


Aug. 1943

Lloyd L. Jensen
County Surveyor