
#1424

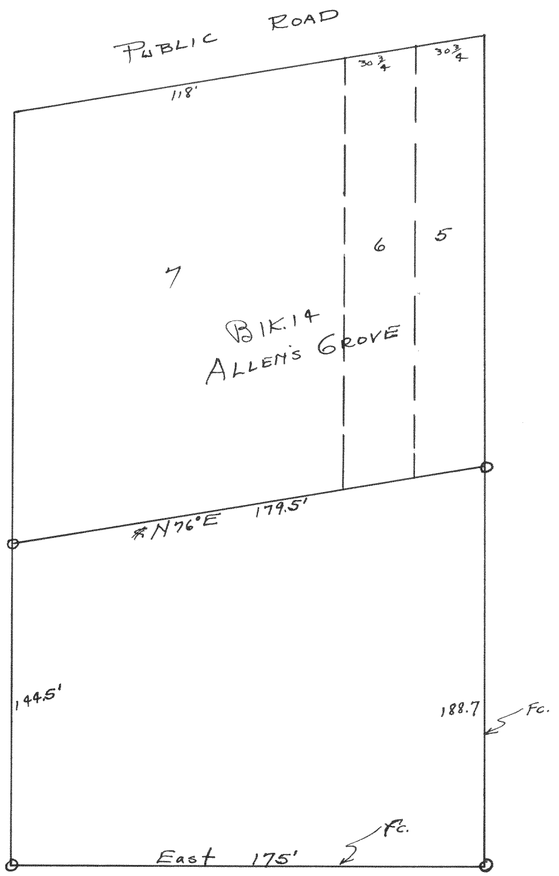


Plat of survey of a parcel of land lying South of Lots 5, 6 & 7 of Blk. 14 of Allens Grove.

Oct. 1943

Lloyd L. Jensen
County Surveyor

#1425

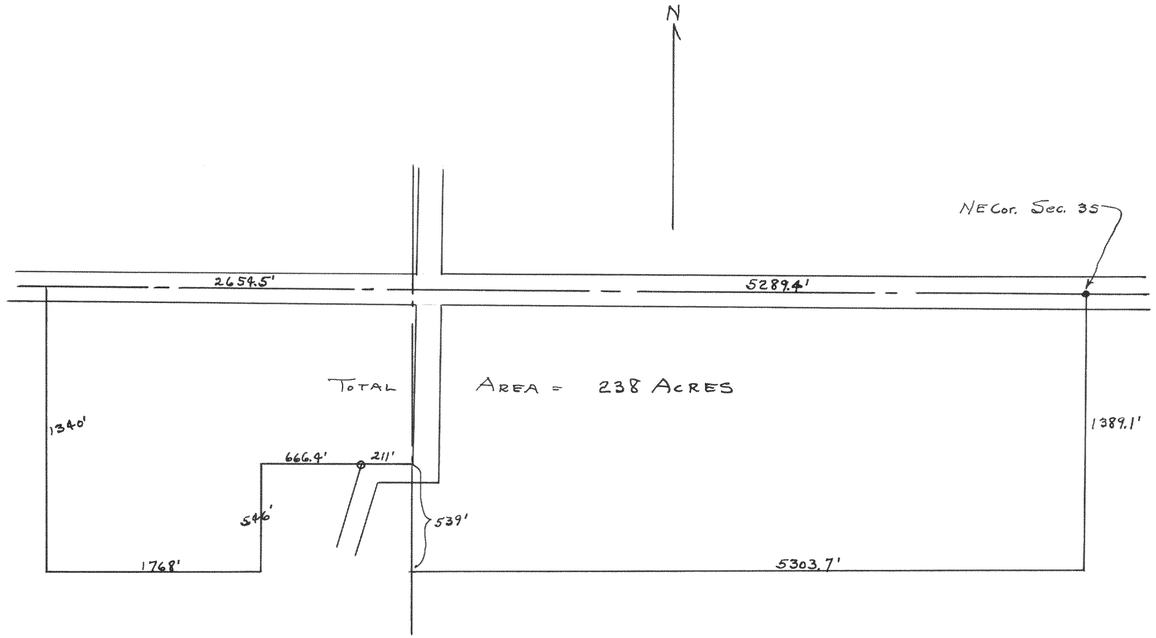

Plat of ferme line survey of part of Sections 34 and 35 of T1N R16E

Nov. 1943

Lloyd L. Jensen
County Surveyor