
#1426

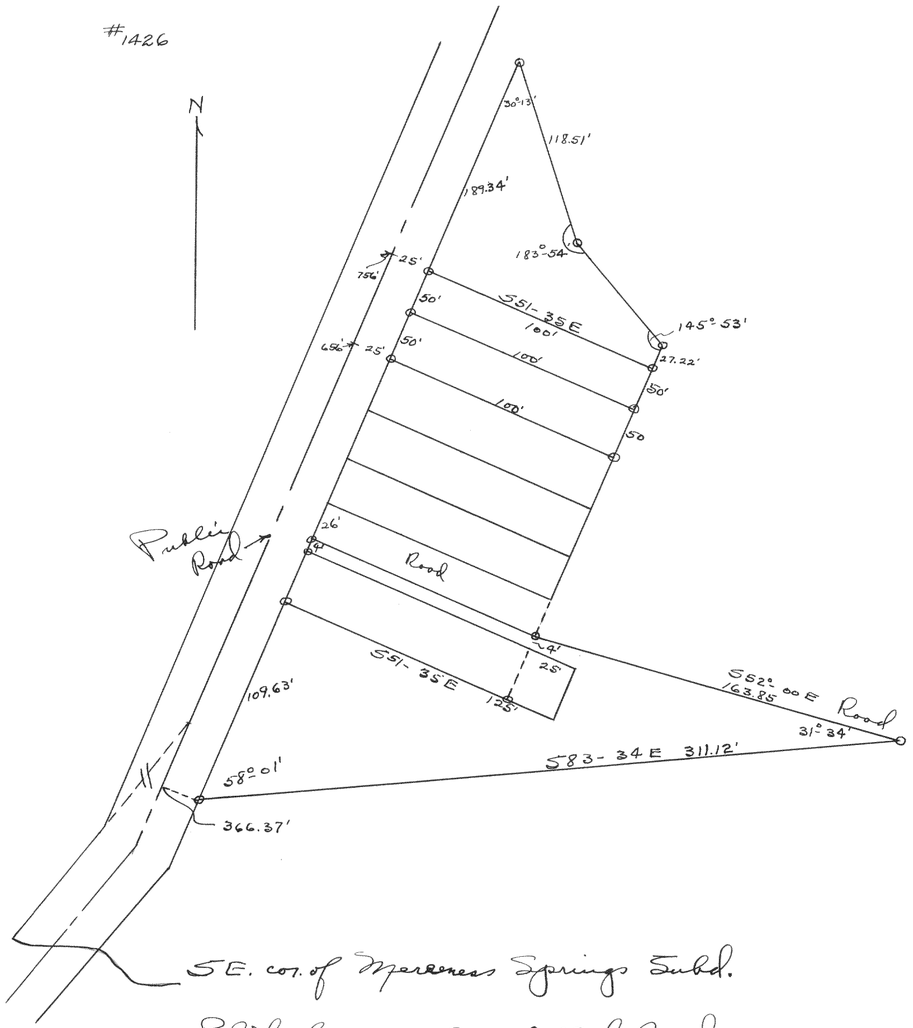


SE. cor. of Mereness Springs Subd.

Plat of survey of unplatted land in Section 22, T27R16E.

Nov. 1943

Floyd L. Jensen
County Surveyor

#1427

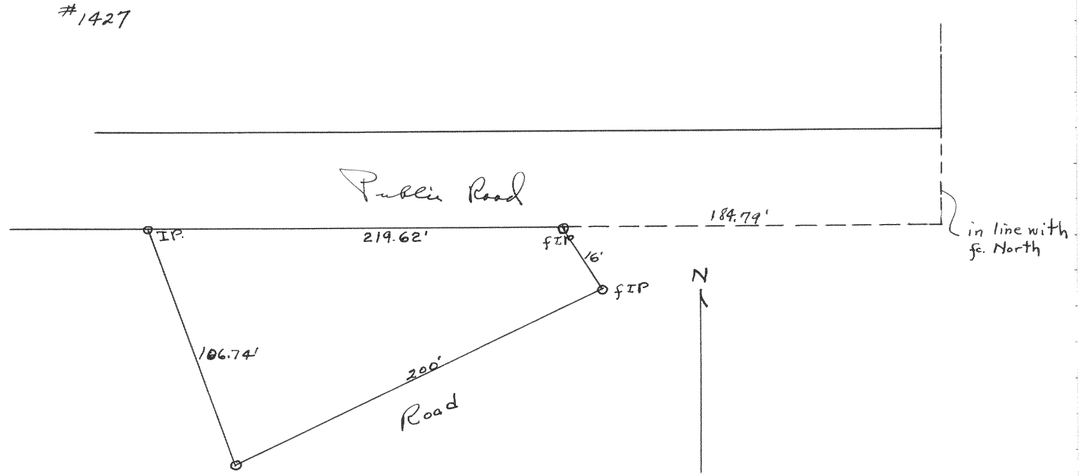


Sept. 1943

Floyd L. Jensen
County Surveyor