
#1430

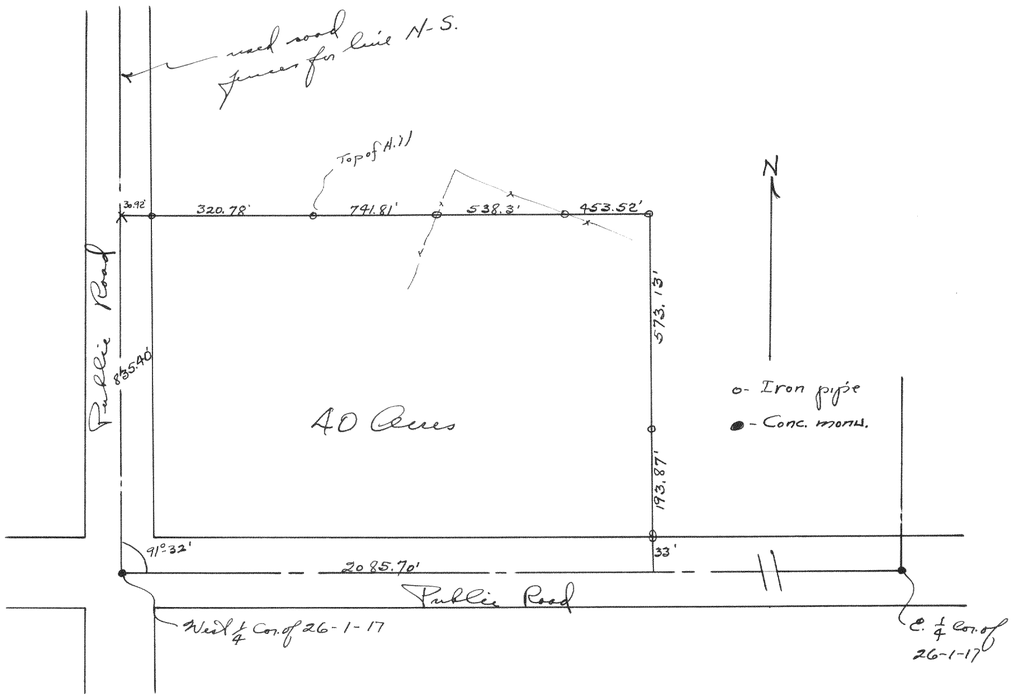


Plat of survey of a parcel of land located in the Northwest 1/4 of Section 26, T1N R1E.

Sept. 1943

Lloyd L. Jensen
County Surveyor.

#1431

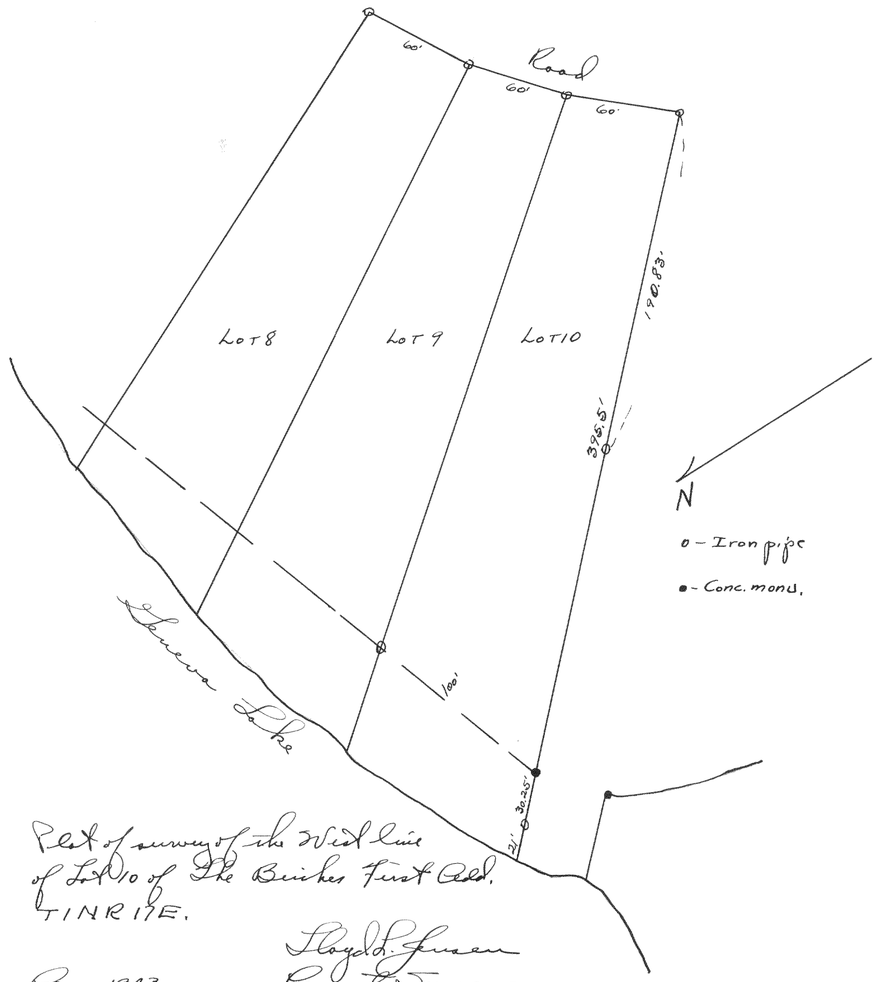

Plat of survey of the West line of Lot 10 of The Birches First Add. T1N R1E.

Aug. 1943

Lloyd L. Jensen
County Surveyor