
#1432

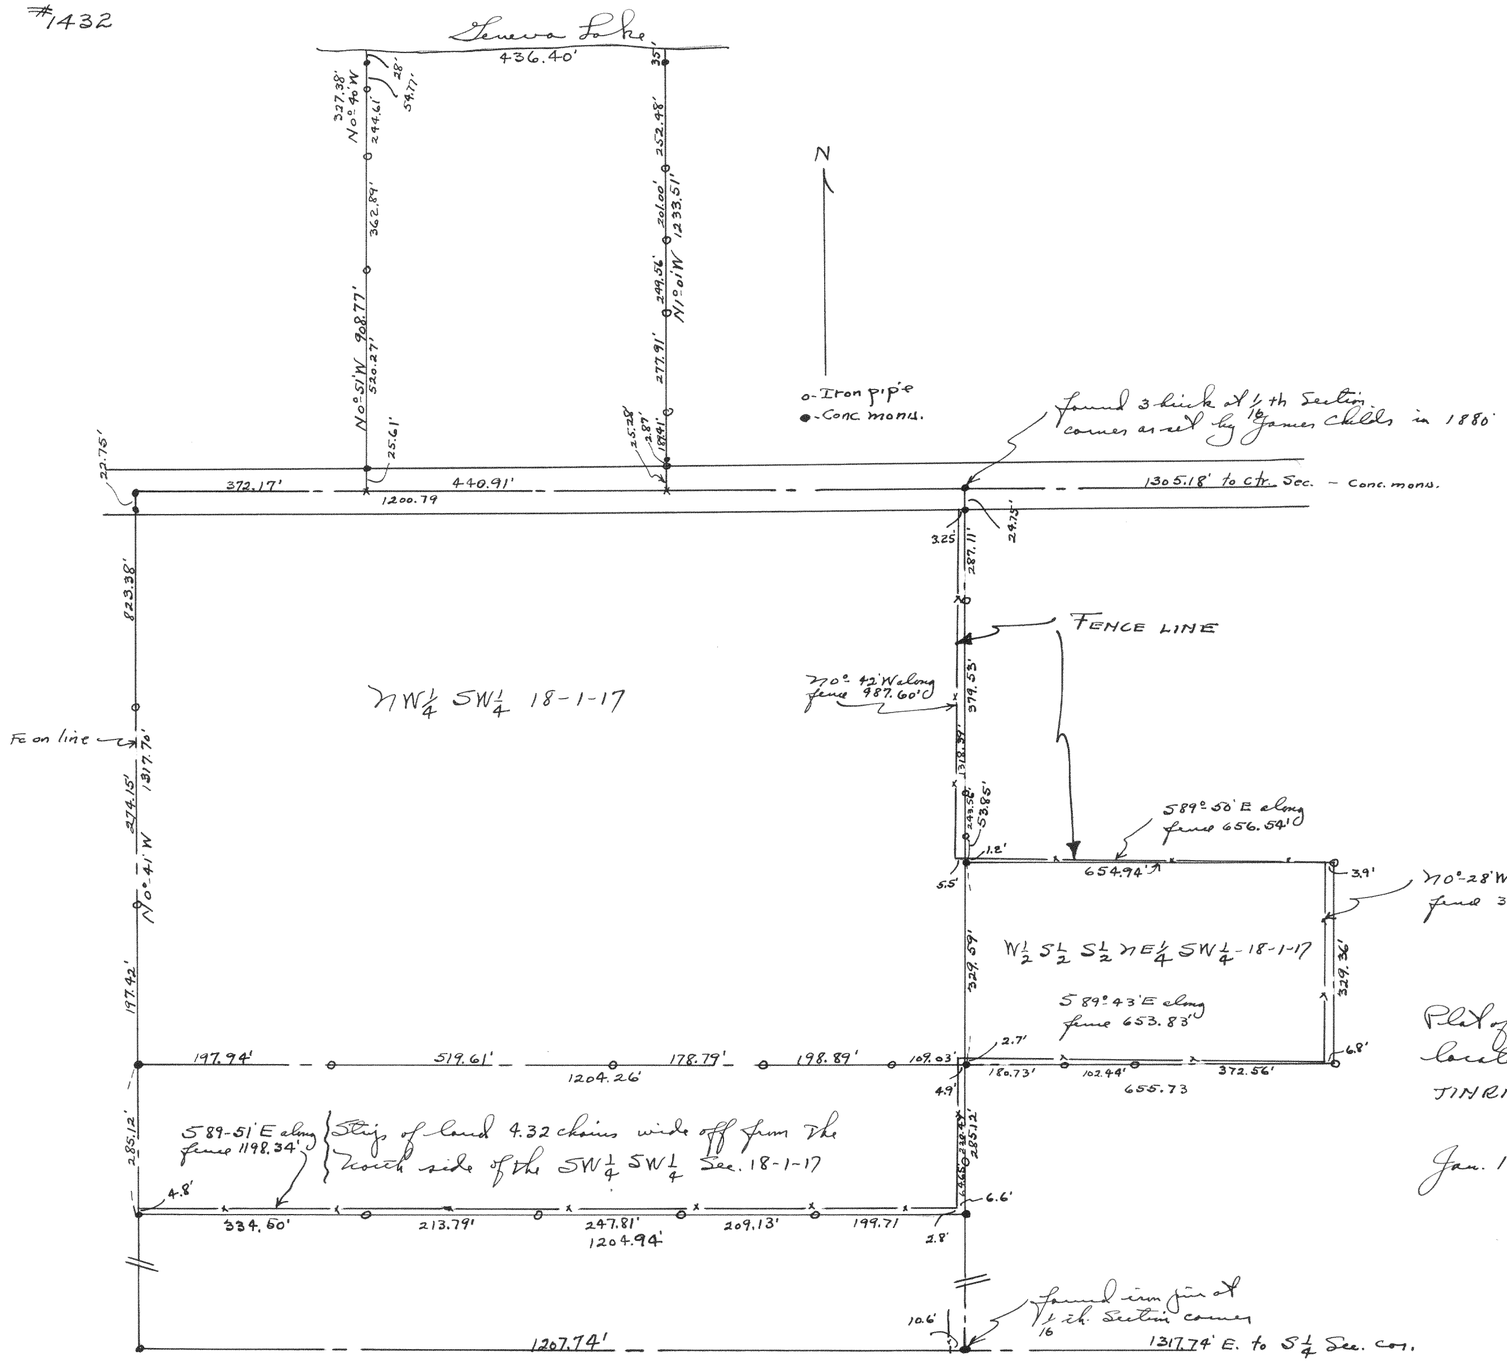

Plat of survey of the Coy Estate located in fractional Section 18, T1N R17 E.

Jan. 1944

Lloyd A. Jensen
County Surveyor