
#1435

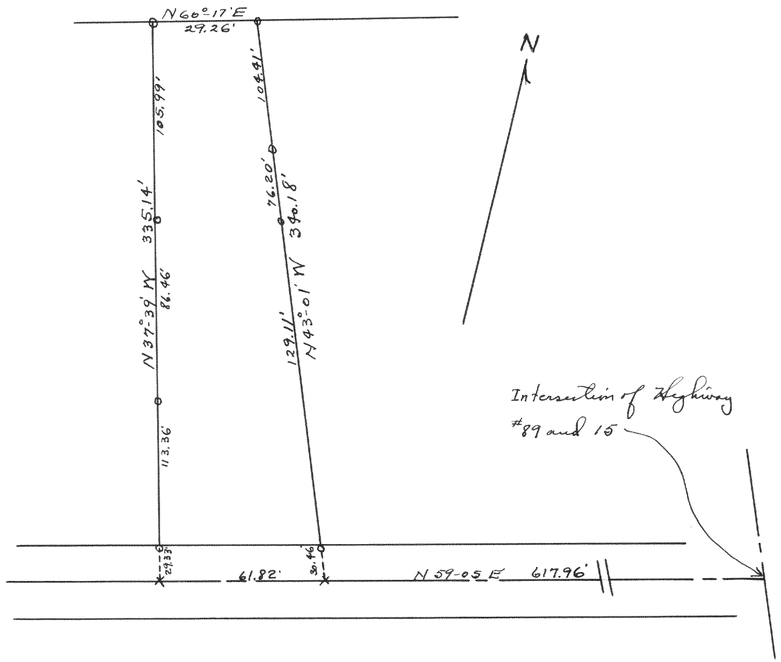


Plat of survey of the Smalls property in Section (SW¼) 27-2-15.

Nov. 1943

Lloyd L. Jensen
County Surveyor

#1436

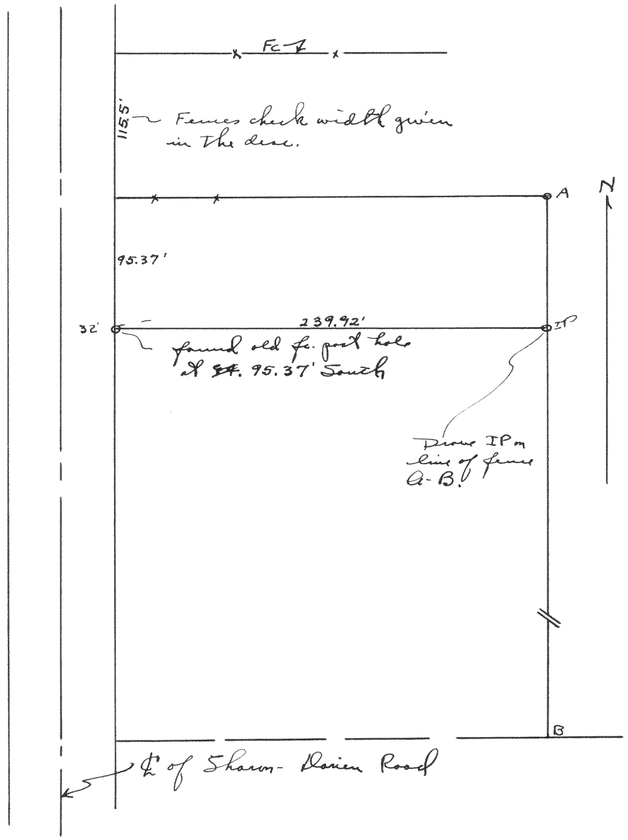

Plat of survey of a parcel of land in Sec. 27-2-15 for Mrs. Duncomb.

Oct. 1943

Lloyd L. Jensen
County Surveyor