
#1437

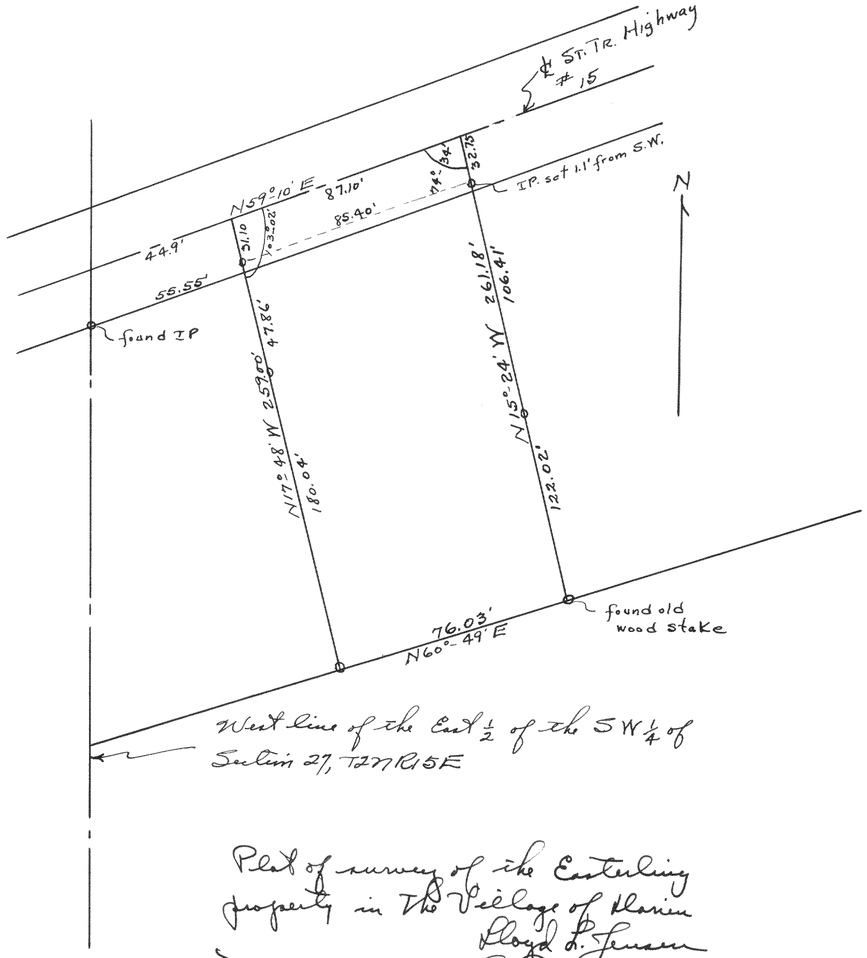




Nov. 1943

Floyd L. Jensen
County Surveyor

#1438

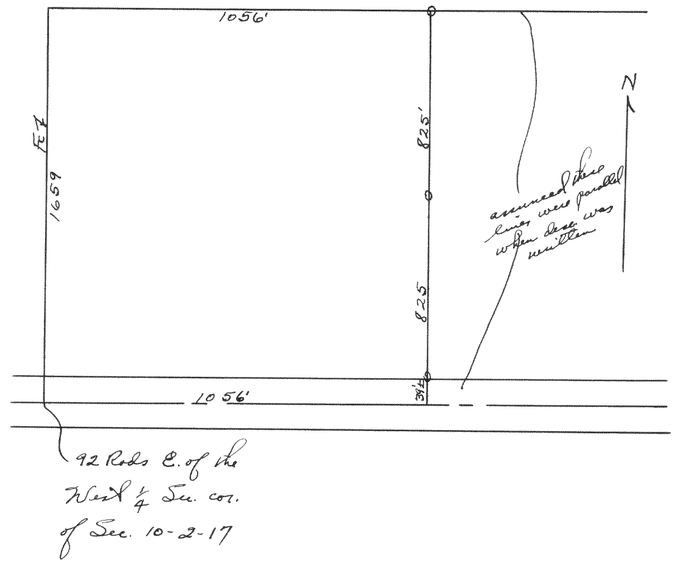

Plat of fence line survey of a 40 acre parcel of land in Section 10-2-17

Nov. 1943

Floyd L. Jensen
County Surveyor