
#1439

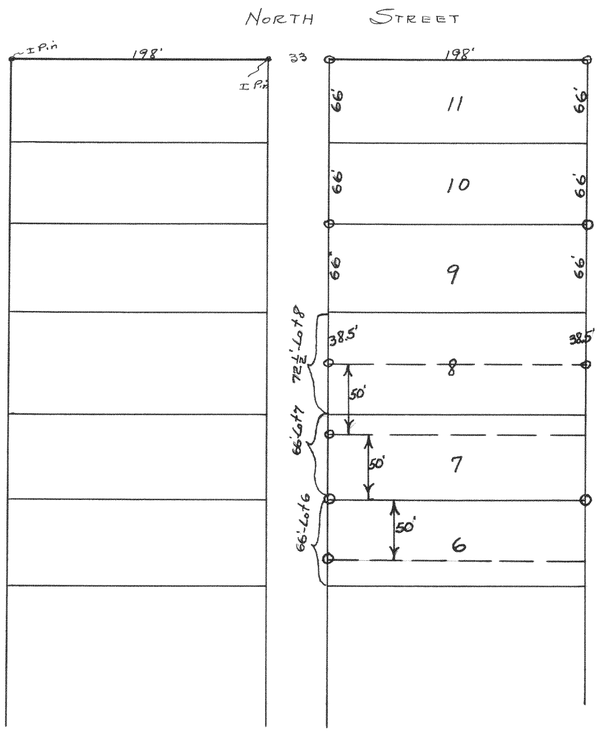


Plat of N. 38½' of Lot 8 and Lots 9-10 & 11 of Blk. 2 of Edwards Add. to East Troy.

Nov. 1943

Lloyd L. Jensen
County Surveyor

#1440

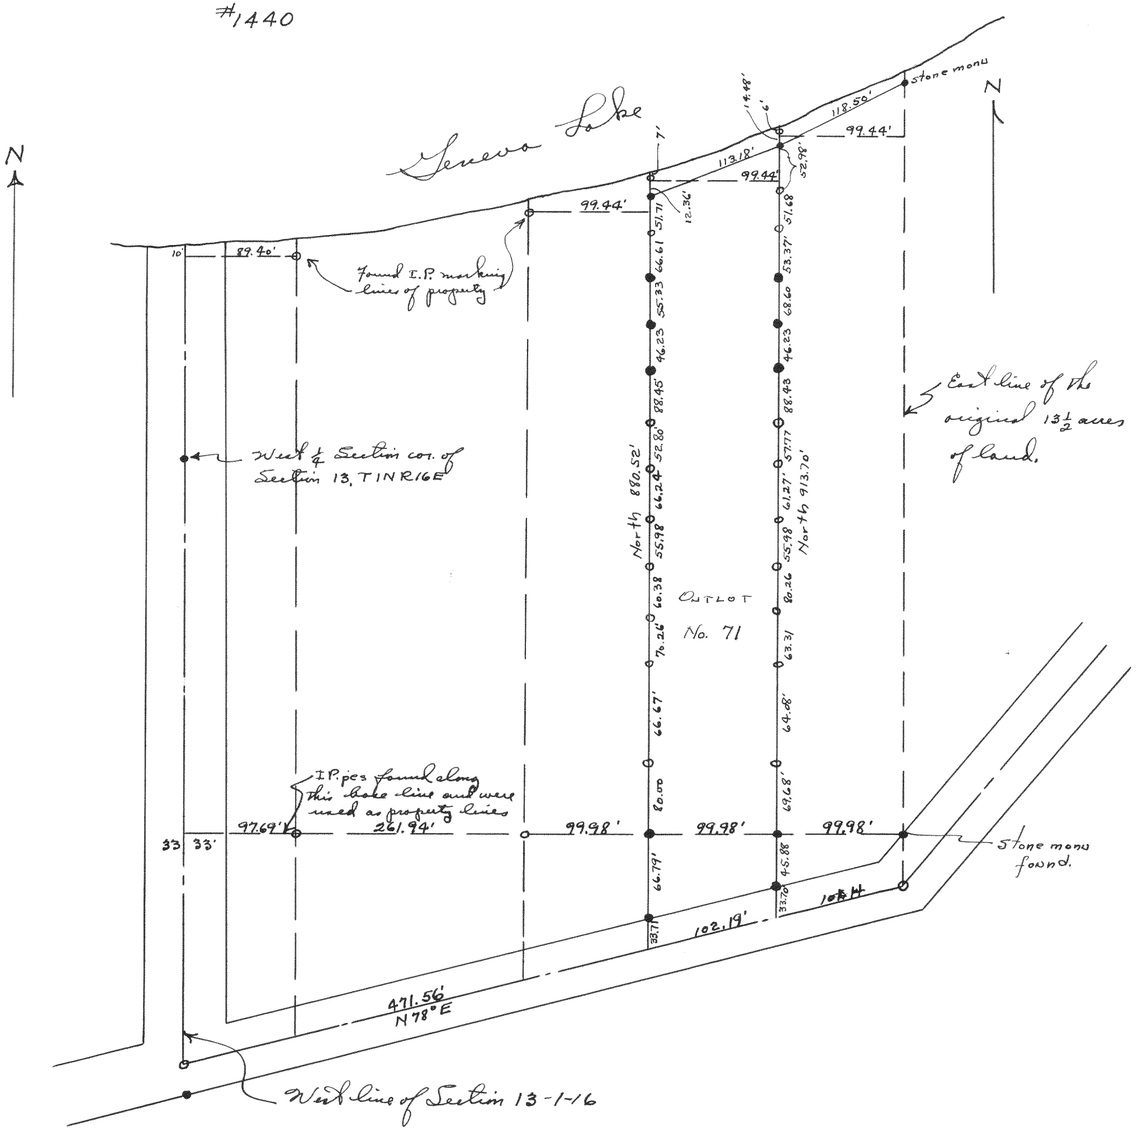

Plat of survey of land located in the West ½ of Fractional Section 13, T1N R16E, Village of Fontana.

Sept. 1943

Lloyd L. Jensen
County Surveyor