
#1441

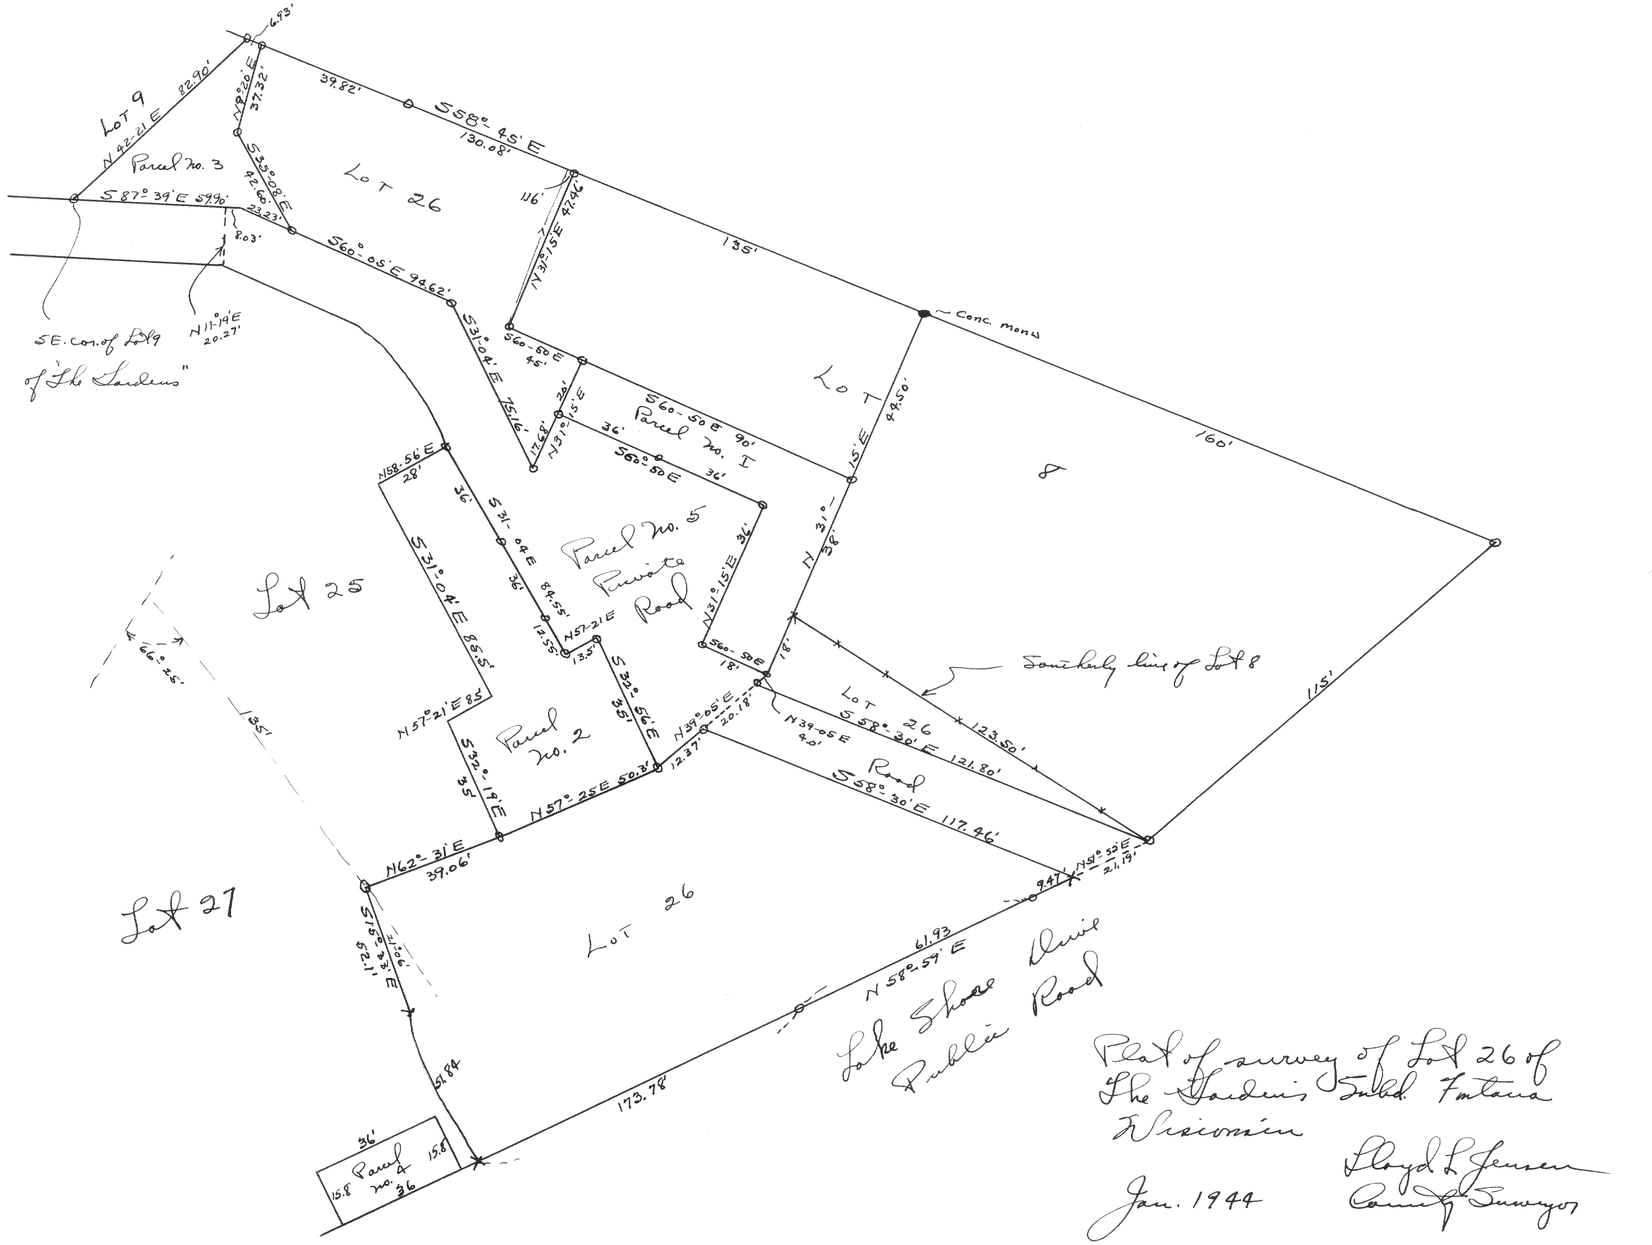

Plat of survey of Lot 26 of The Gardens Subd. Fontana Wisconsin

Jan. 1944

Lloyd L. Jensen
County Surveyor