
#1444

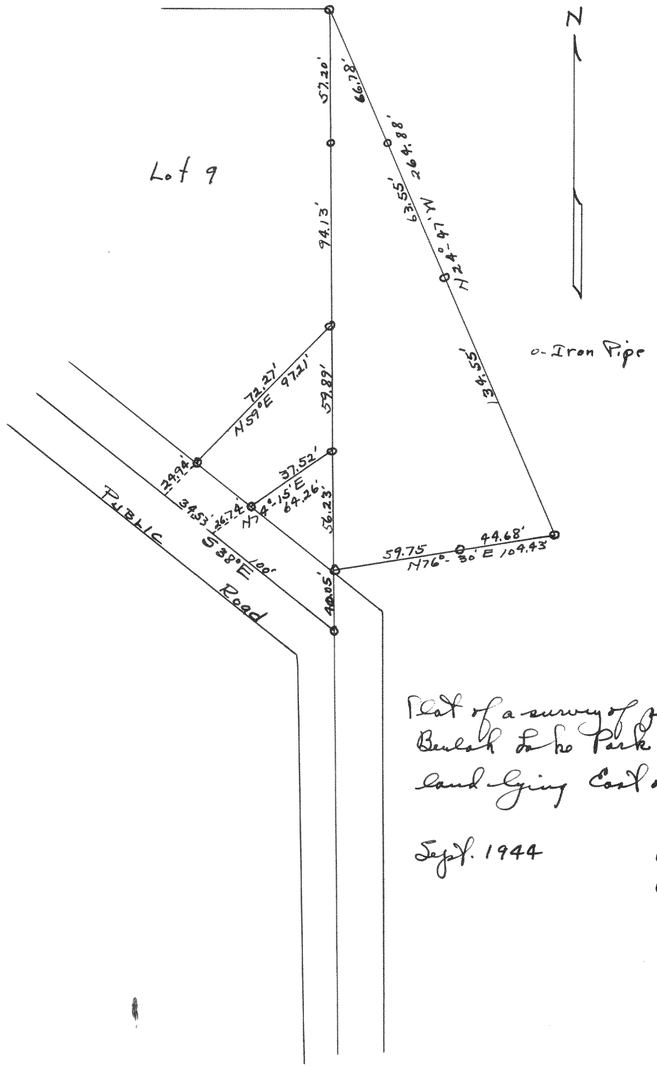


Plat of a survey of part of Lot 9 of Beulah Lake Park and of unplatted land lying East of it.

Sept. 1944

Lloyd L. Jensen
County Surveyor

#1445

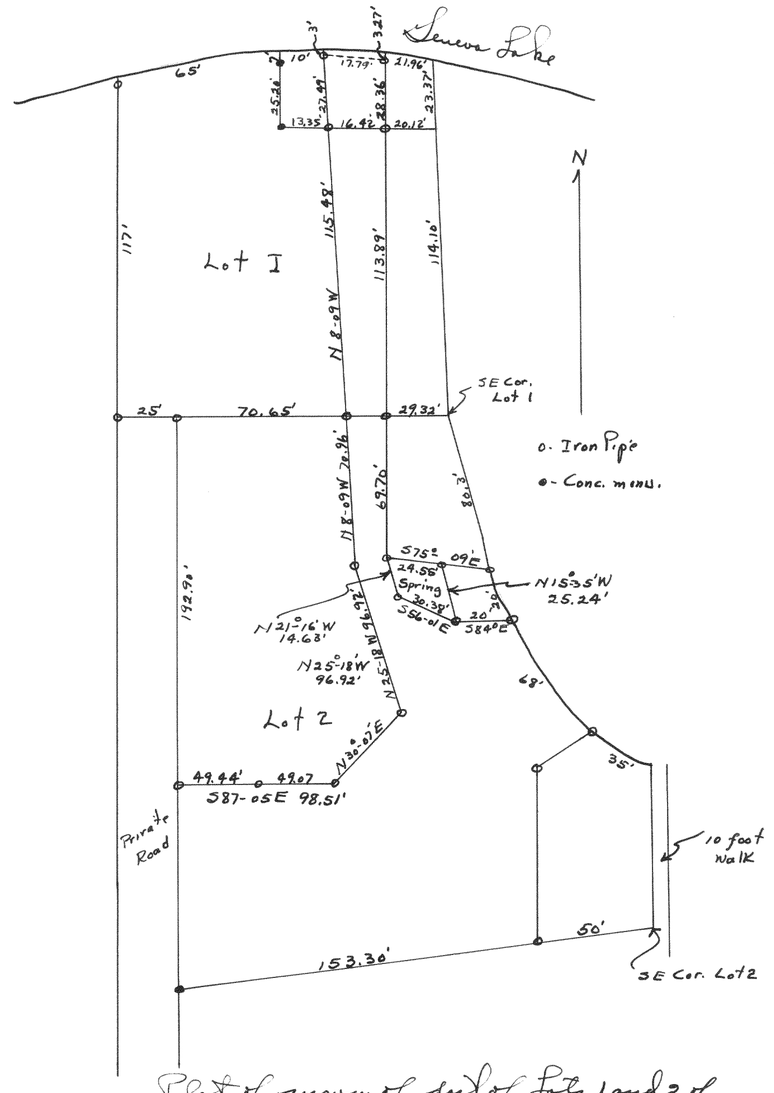

Plat of survey of part of Lots 1 and 2 of Blk. 2 of Woodale Add. Section 9, T1N R17E.

Dec. 1944

Lloyd L. Jensen
County Surveyor