
SURVEY NO. 1212

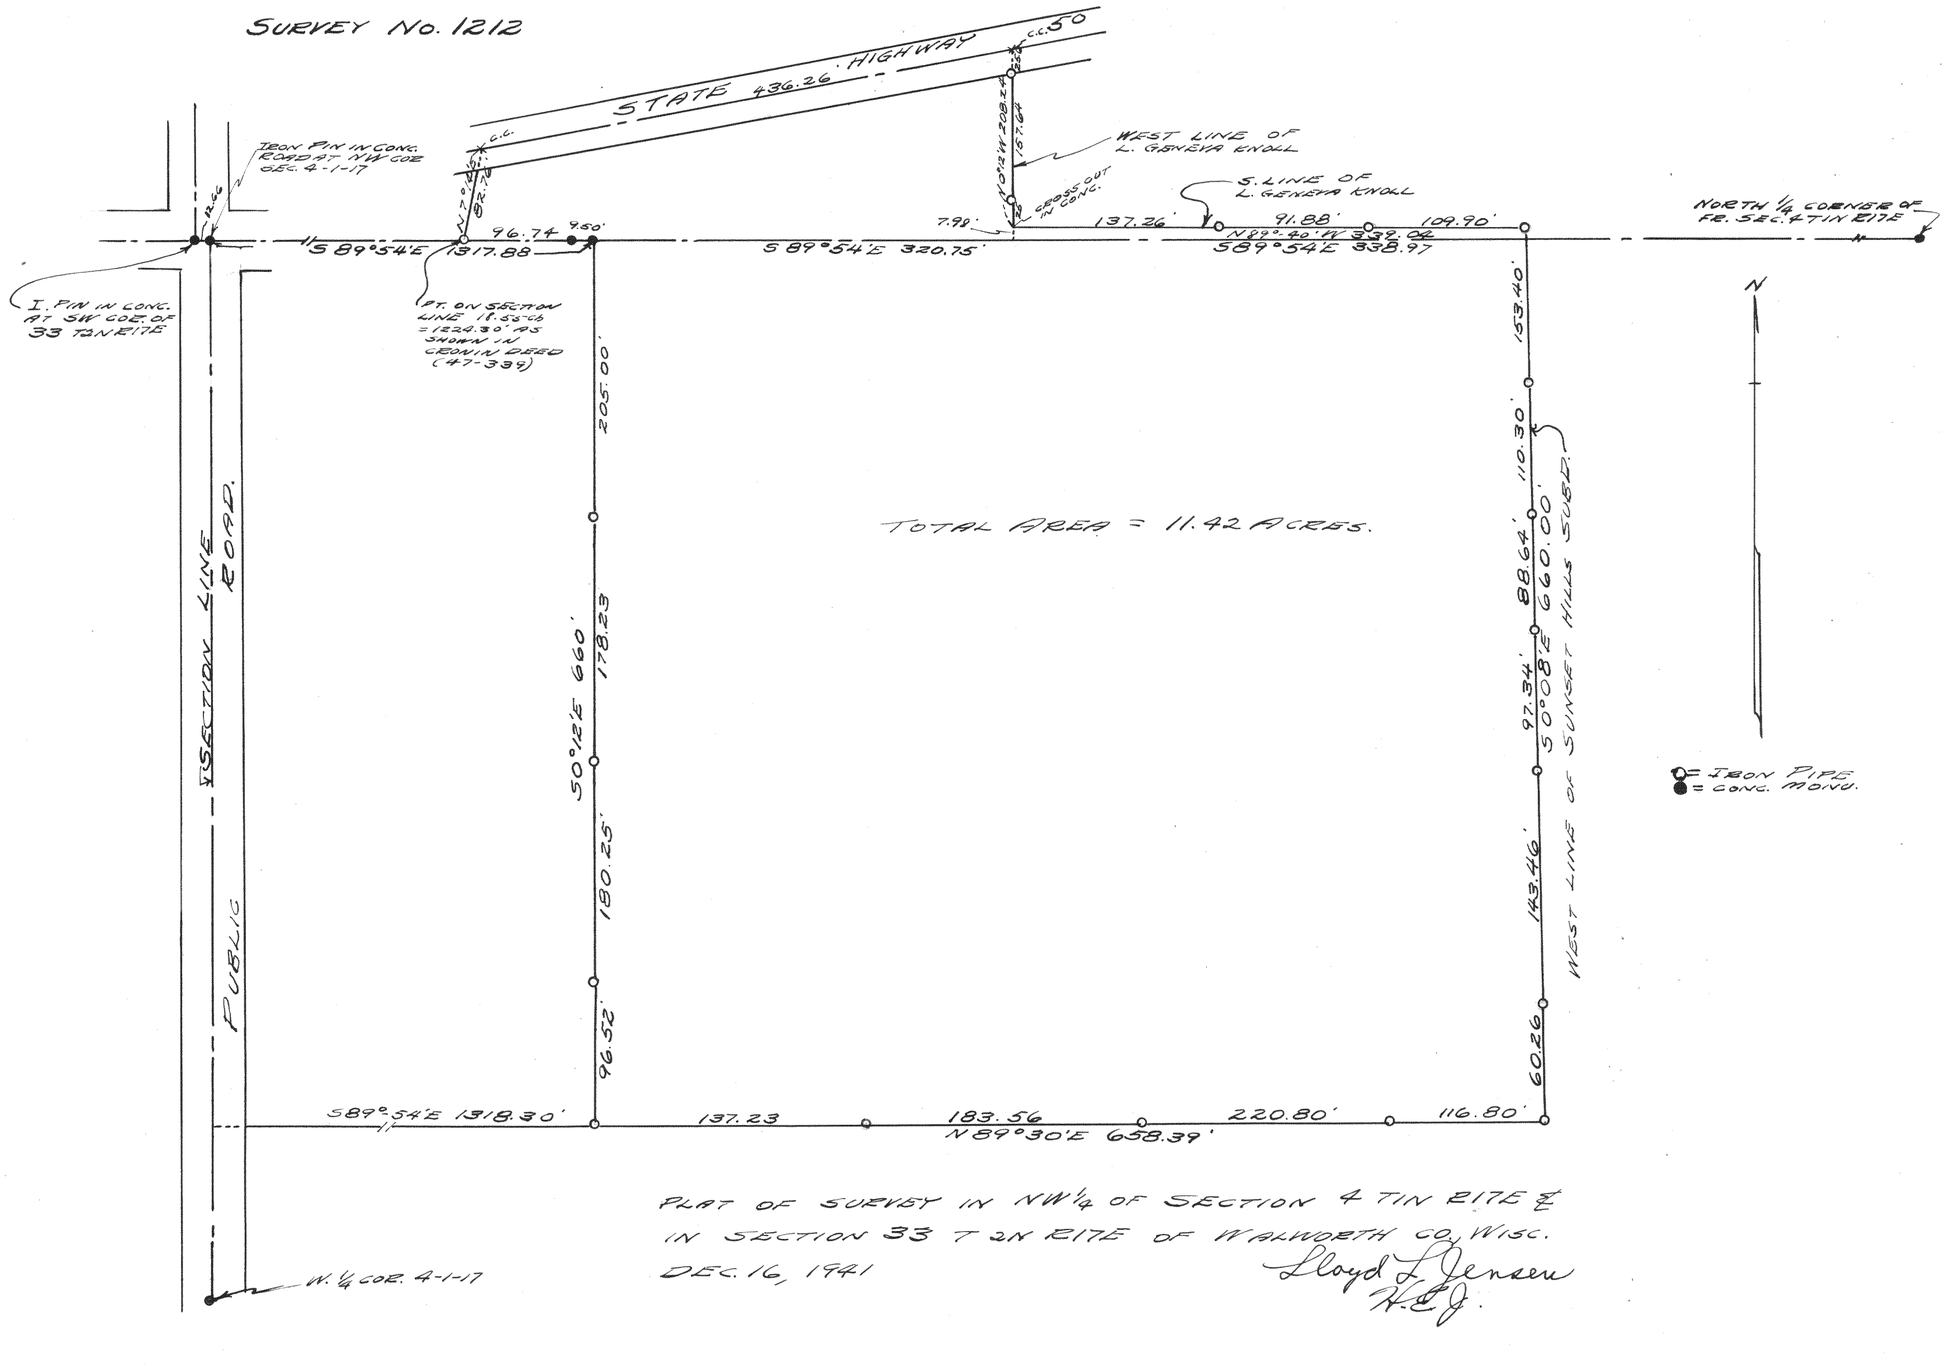

PLAT OF SURVEY IN NW1/4 OF SECTION 4 T1N R17E & IN SECTION 33 T2N R17E OF WALWORTH CO, WISC.
DEC. 16, 1941

Lloyd L. Jensen
R.E.J.