
#1446

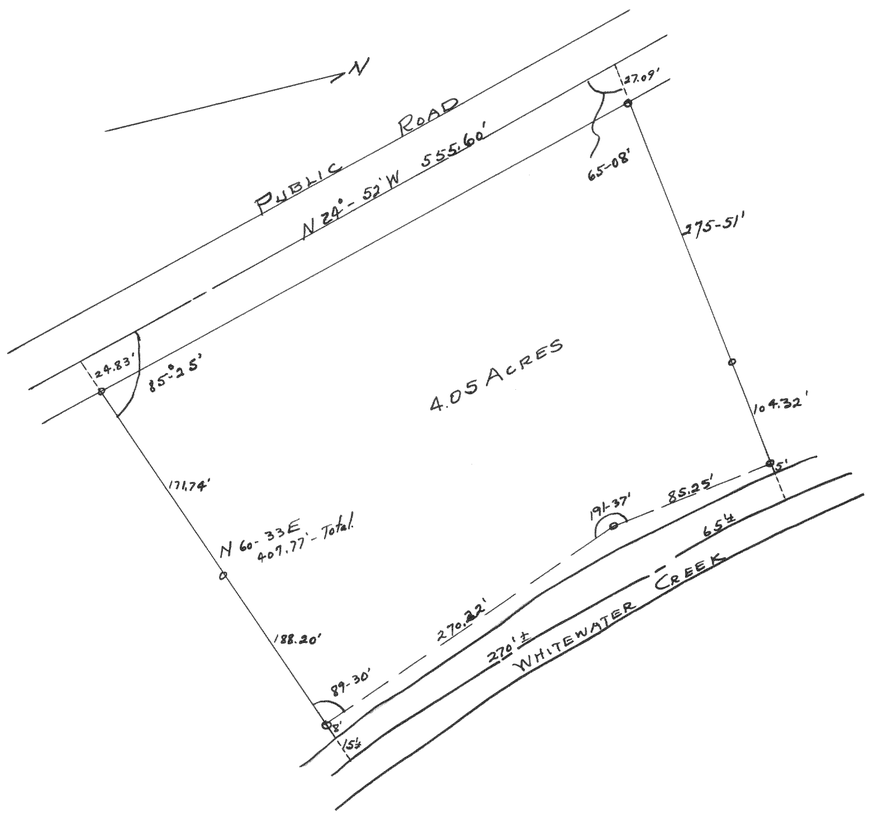


Plat of survey of a parcel of land in the SW¼ of Section 33, T5N R15E of Jefferson County Wisconsin

Nov. 1944

Floyd L. Jensen
County Surveyor

#1447

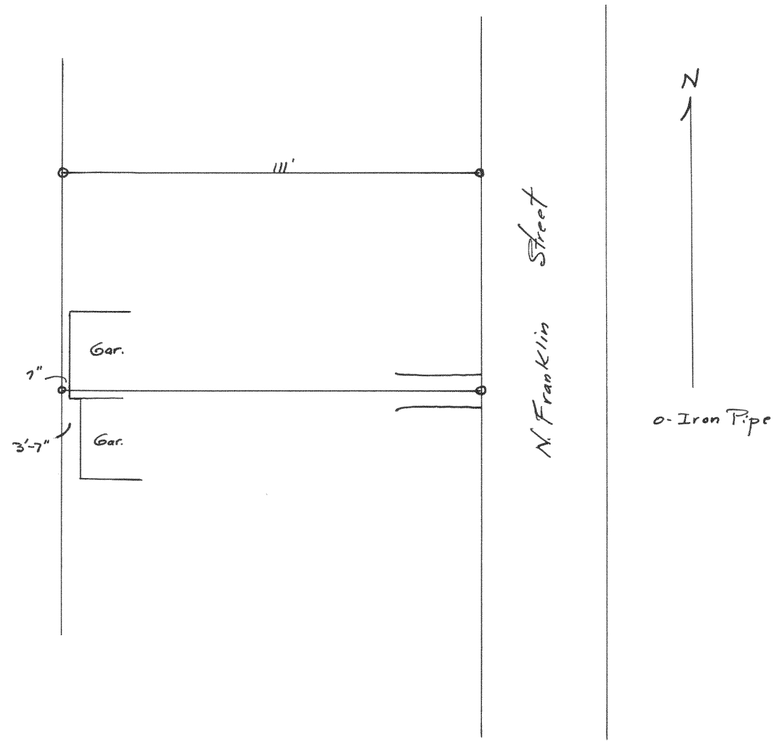

Plat of survey of Lot 5 - Blk 2 of Cooper and Cox's Add. to the City of Whitewater.

Sept. 21, 1944

Floyd L. Jensen
County Surveyor