
#1455

#1456

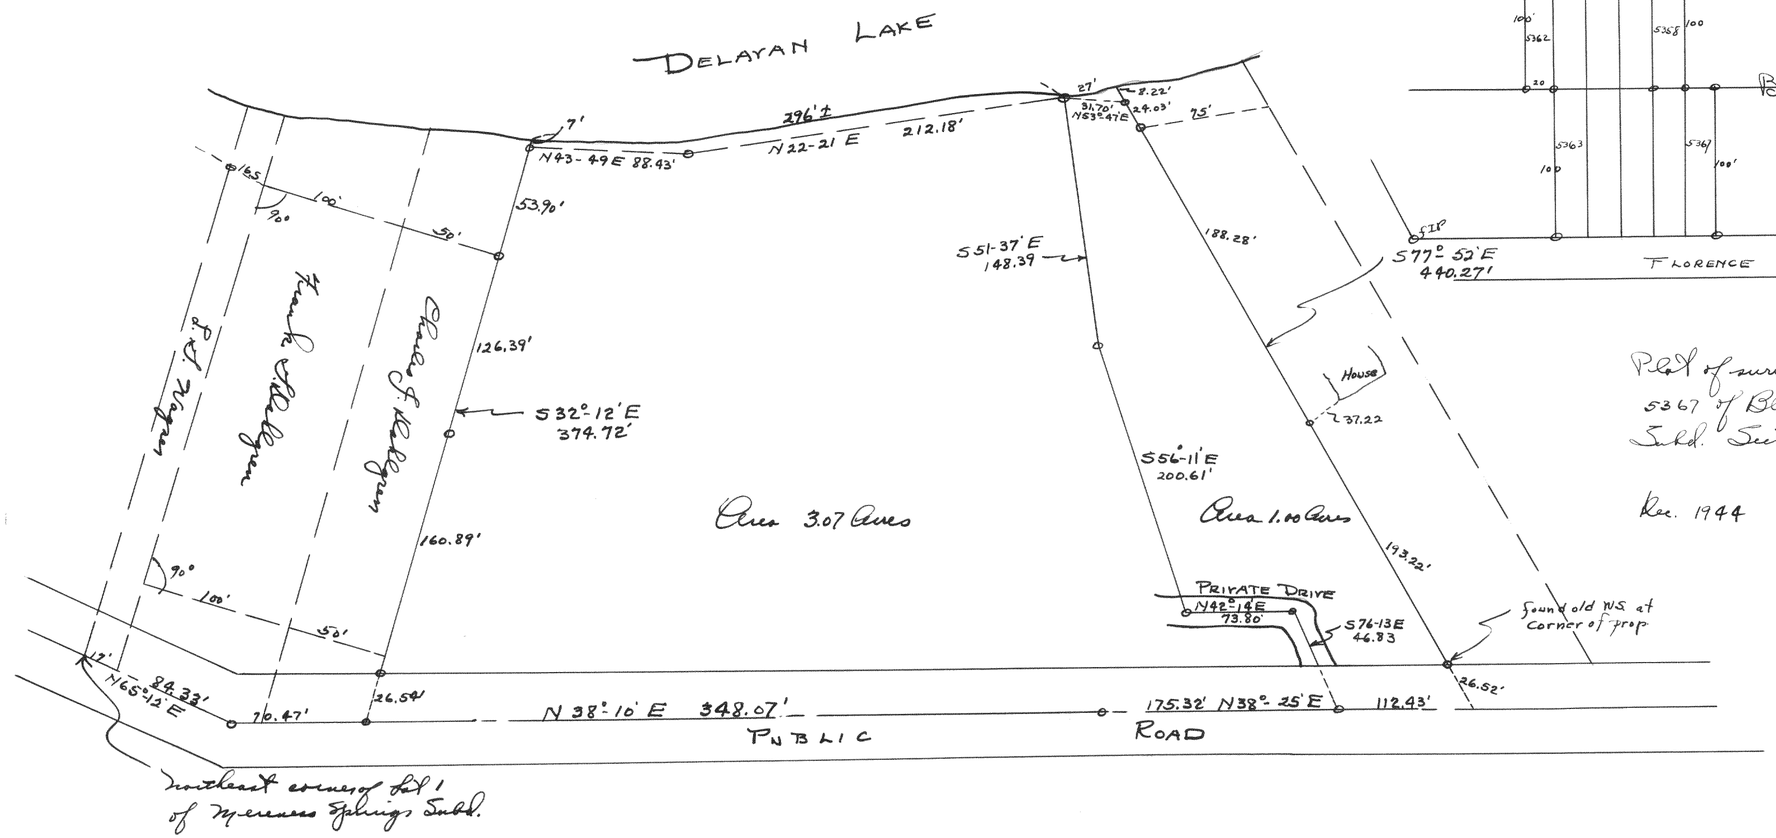

Plat of survey of lots 5358 to 5367 of Blk. 99 of Peel Lake Subd. Section 15, T7N R18E

Dec. 1944

Lloyd L. Jensen
County Surveyor



Lloyd L. Jensen
County Surveyor