
#1457

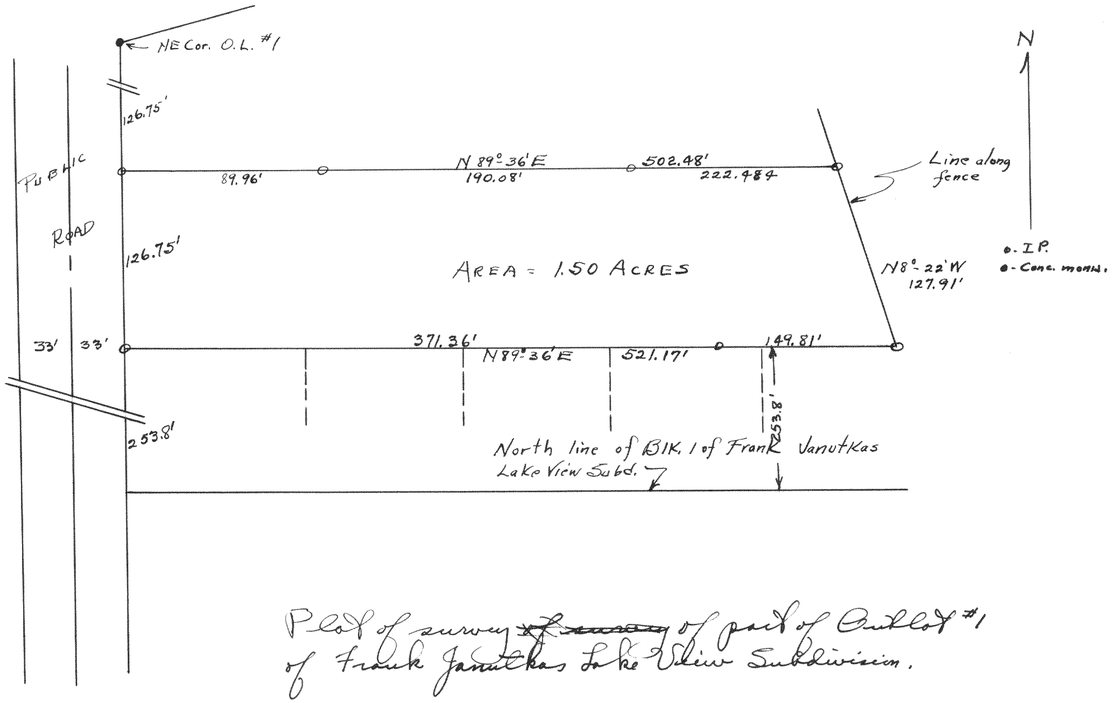


Plat of survey ~~of~~ of part of Outlot #1 of Frank Janutkas Lake View Subdivision.

Nov. 1944

Lloyd L. Jensen
County Surveyor

#1458

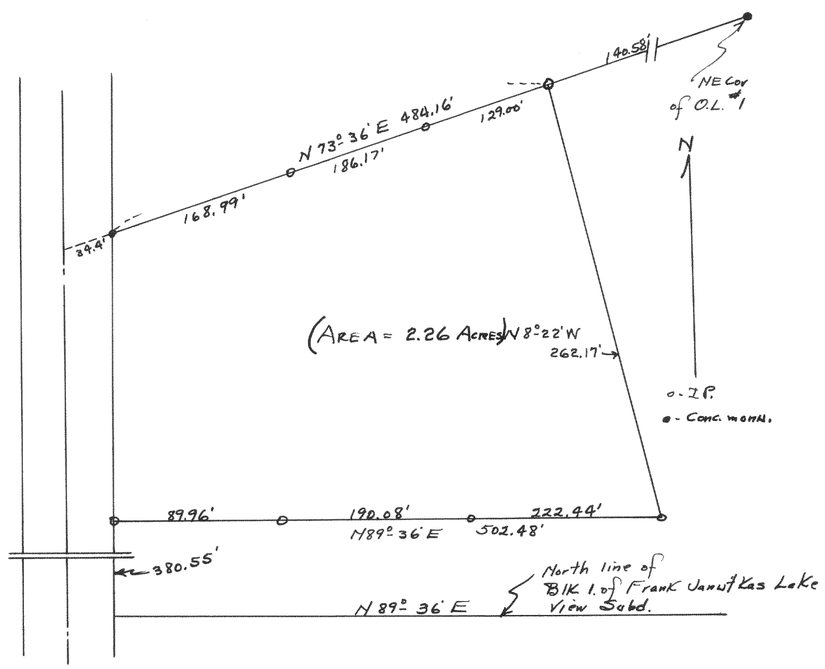

Plat of survey of part of Outlot #1 of Frank Janutkas Lake View Subdivision.

Nov. 1944

Lloyd L. Jensen
County Surveyor