
#1461

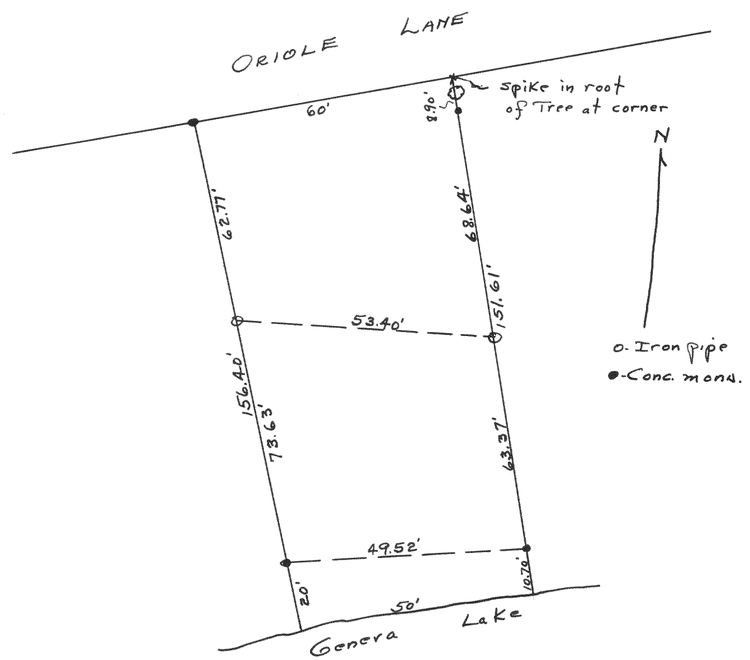


Plat of survey of Lot 12 of Blk. A of Lisco Beach Subdivision, located in Sections 5, T1N R17E of Walworth County Wisconsin.

May 1944

Floyd L. Jensen
County Surveyor

#1462

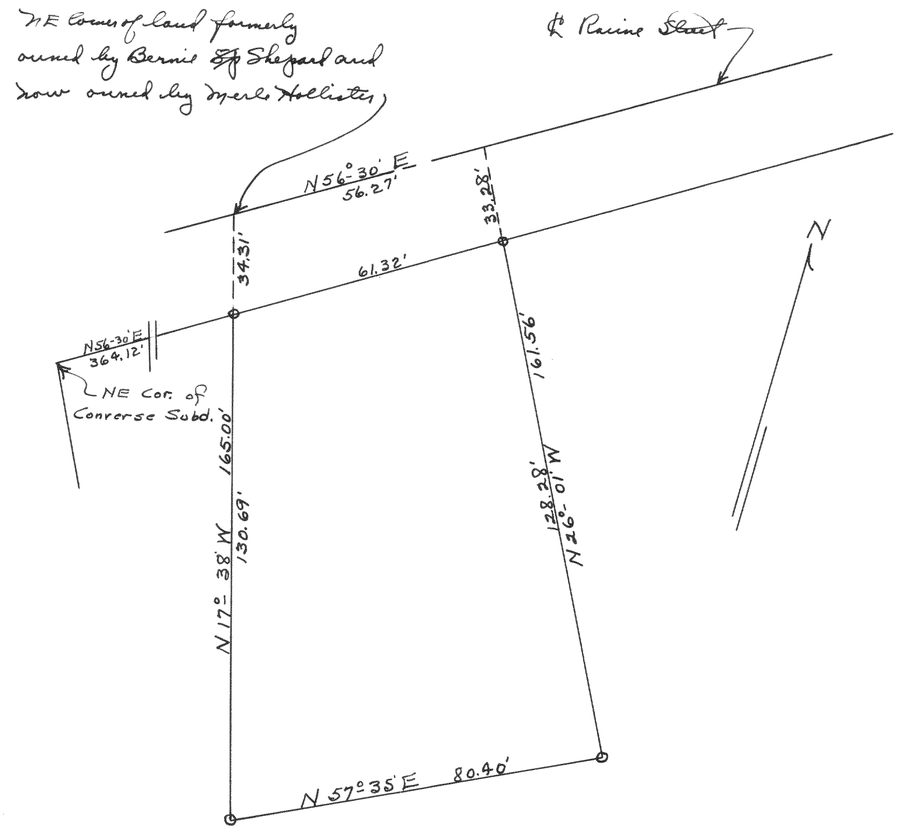

Plat of survey of a parcel of land located in the NE¼ of Section 17, T2N R16E - City of Delavan

May 1944

Floyd L. Jensen
County Surveyor