
#1463

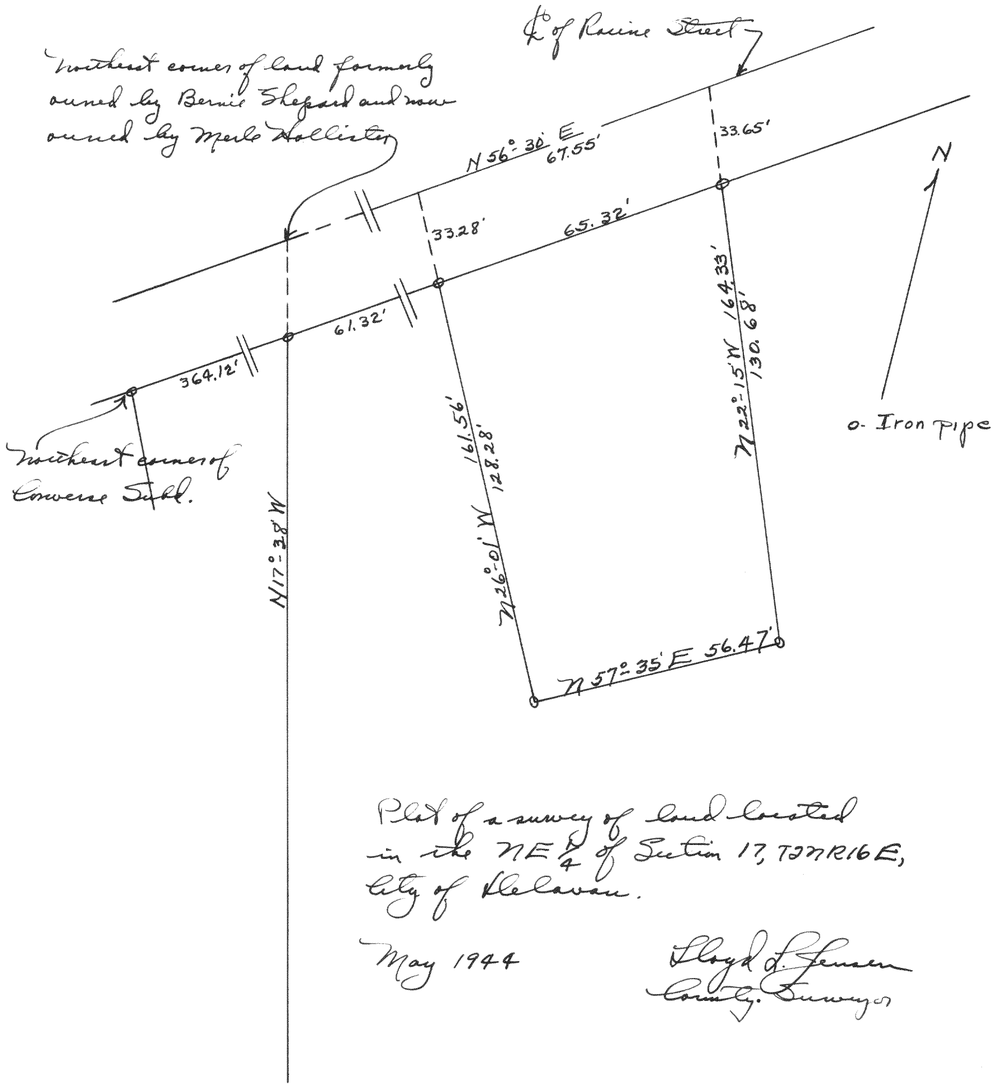



May 1944

Lloyd L. Jensen
County Surveyor

#1464

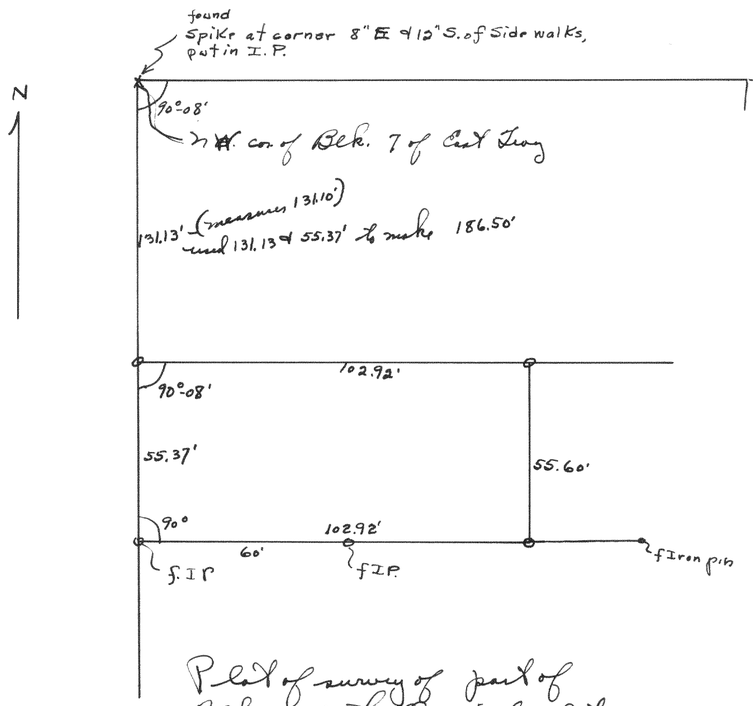

Plat of survey of part of Blk. 7 of the Original plat of the Village of East Troy.

April 1944

Lloyd L. Jensen
County Surveyor