
#1465

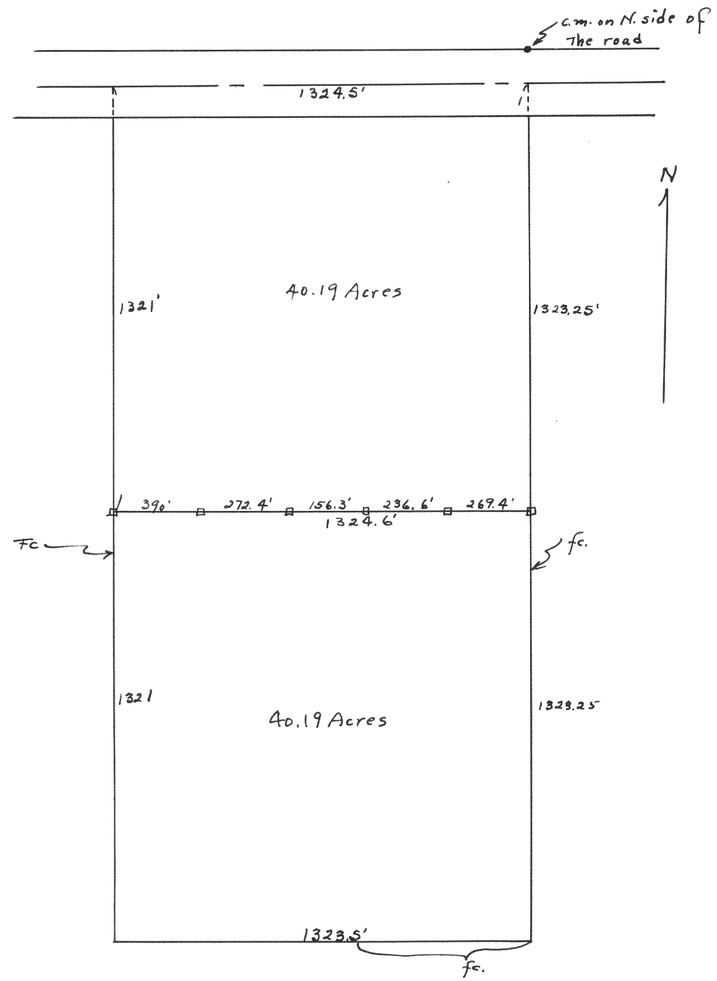


Plat of a fence line survey of the West ½ of the SW ¼ of Section 19, T17NR17E to divide the 80 acres across the center of the property.

May 1944

Lloyd L. Jensen
County Surveyor

#1466

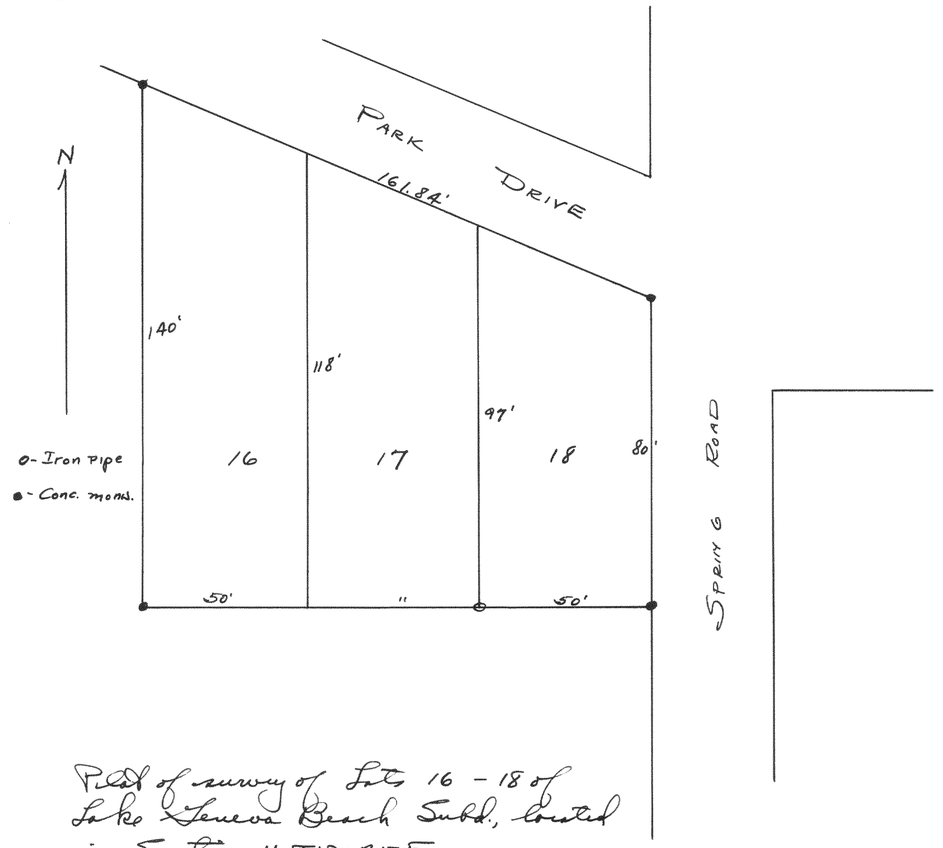

Plat of survey of Lots 16 - 18 of Lake Geneva Beach Subd., located in Section 11, T17NR17E.

June 1944

Lloyd L. Jensen
County Surveyor