
#1467

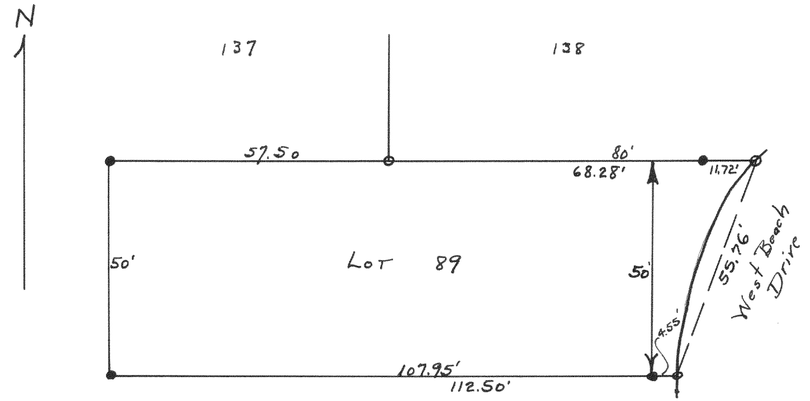


Plat of survey of Lot 89 of Lake Geneva Beach Subd., located in Section 11, T1N R17E of Walworth County Wisconsin

July 1944

Floyd L. Jensen
County Surveyor

#1468

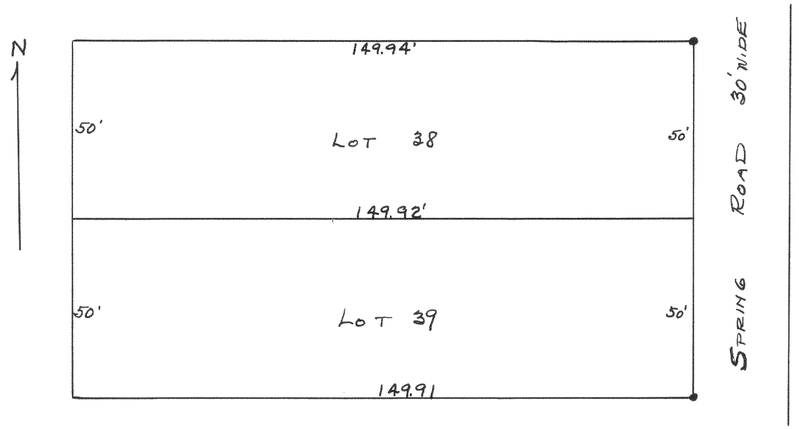

Plat of survey of Lots 38 and 39 of Lake Geneva Beach Subd., located in Section 11, T1N R17E of Walworth County Wisconsin.

Aug. 1944

Floyd L. Jensen
County Surveyor