
#1469

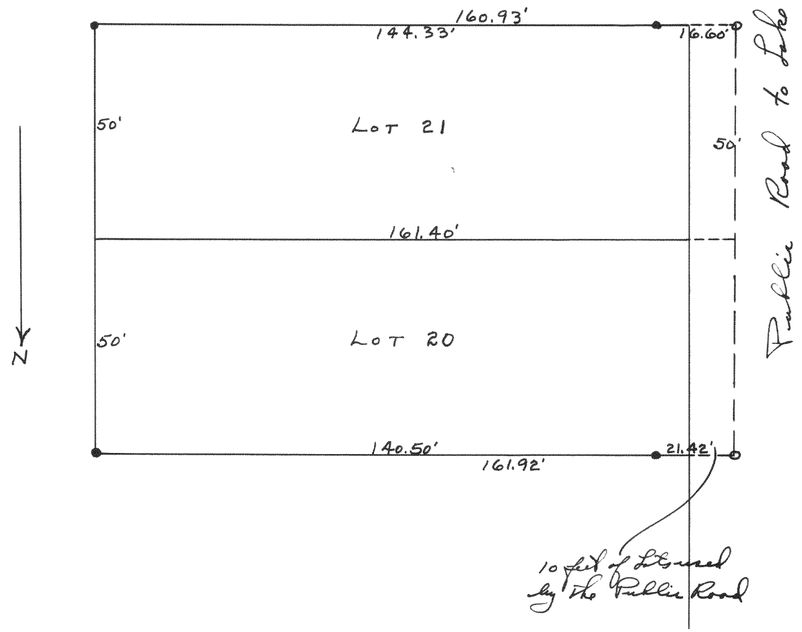


Plat of survey of Lots 20 and 21 of Lake Geneva Beach Subdivision, located in Section 11, T1N R17E of Walworth County Wisconsin.

Aug 2, 1944

Lloyd L. Jensen
County Surveyor

#1470

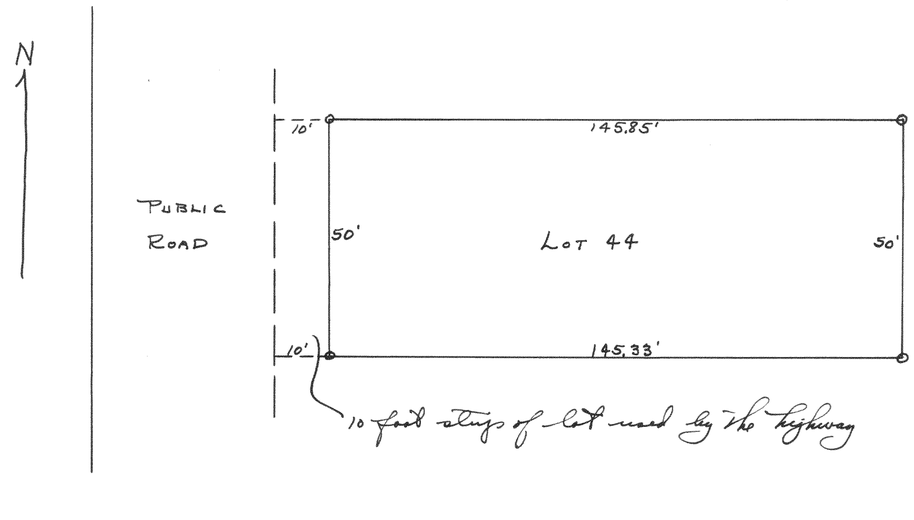

Plat of survey of Lot 44 of Lake Geneva Beach Subd., located in Section 11, T1N R17E of Walworth County Wisconsin.

Aug. 1944

Lloyd L. Jensen
County Surveyor