
#1471

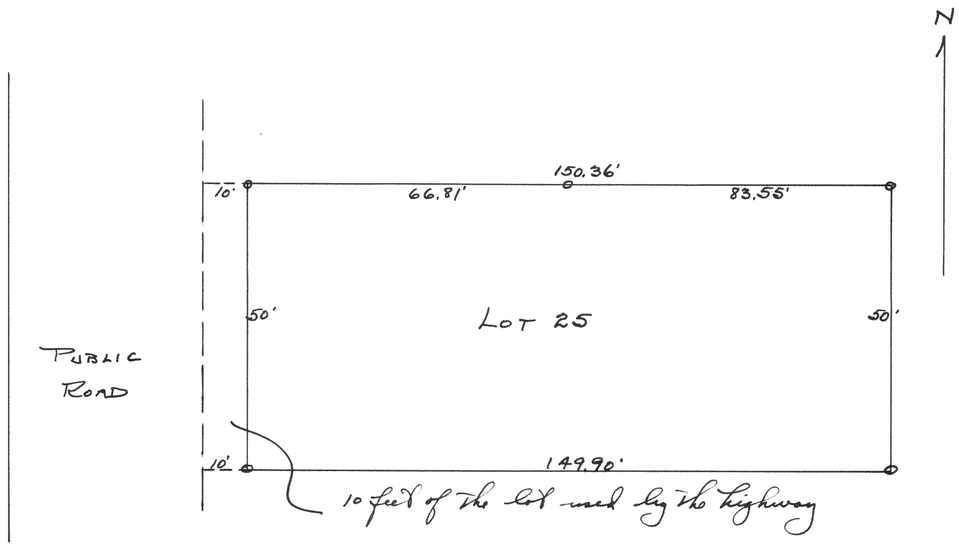


Plat of survey of Lot 25 of Lake Geneva Beach Subdivision, located in Section 11, T1N R17E of Walworth County Wisconsin.

Aug. 1944

Lloyd L. Jensen
County Surveyor

#1472

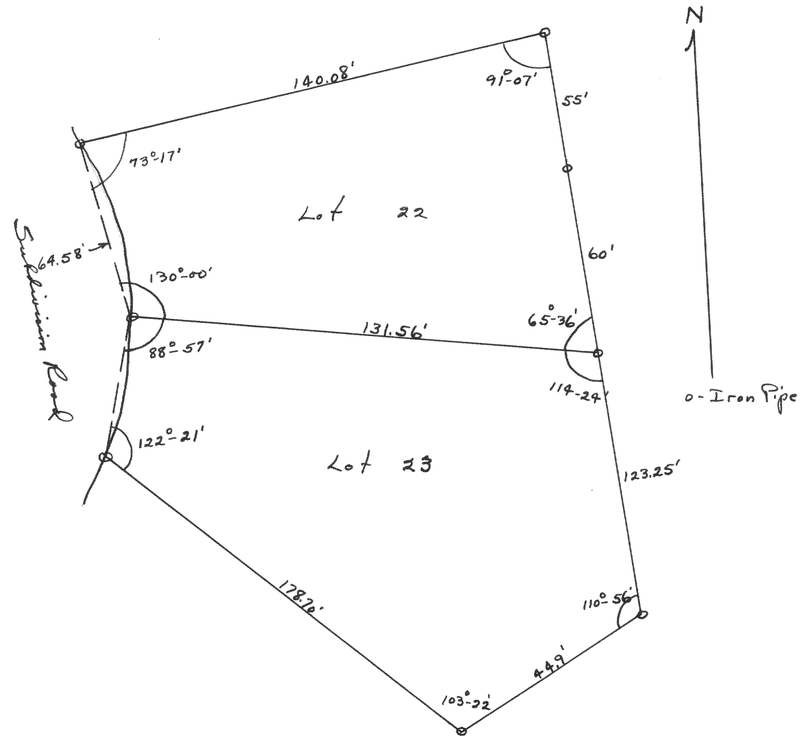

Plat of survey of Lots 22 and 23 of Woodside Add. - Blk. 3 - Located in Fractional Section 9, T1N R17E, Walworth County Wisconsin.

Sept. 1944

Lloyd L. Jensen
County Surveyor